


STATE OF KANSAS  
STATE CORPORATION COMMISSION

Form CP-4

Give All Information Completely  
Make Required Affidavit  
Mail or Deliver Report to:  
Conservation Division  
State Corporation Commission

WELL PLUGGING RECORD

P. O. Box 17027  
Wichita, Kansas 67217  
NORTH

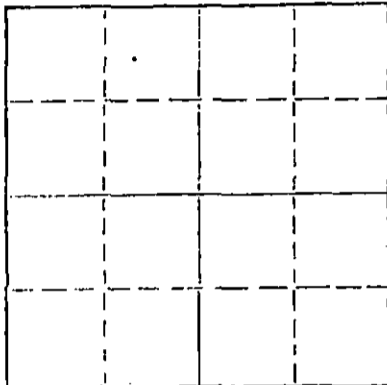

Locate well correctly on above  
Section Plat

Kiowa County, Sec. 14 Twp. 29S Rge. 17W (E) (W)  
Location as "NE/CNW&SW" or footage from lines C NW/4  
Lease Owner Marsh Oil & Associates  
Lease Name Conklin Well No. 2-14  
Office Address c/o Douglas Myers, 509 Union Center, Wichita, Kansas  
Character of Well (completed as Oil, Gas or Dry Hole) D & A  
Date well completed February 9 19 73  
Application for plugging filed February 9 19 73  
Application for plugging approved February 9 19 73  
Plugging commenced February 9 19 73  
Plugging completed February 9 19 73  
Reason for abandonment of well or producing formation D & A

If a producing well is abandoned, date of last production 19  
Was permission obtained from the Conservation Division or its agents before plugging was commenced? Yes

Name of Conservation Agent who supervised plugging of this well G. R. Beiberstein  
Producing formation \_\_\_\_\_ Depth to top \_\_\_\_\_ Bottom \_\_\_\_\_ Total Depth of Well 2900 Feet  
Show depth and thickness of all water, oil and gas formations.

OIL, GAS OR WATER RECORDS

CASING RECORD

FORMATION	CONTENT	FROM	TO	SIZE	PUT IN	PULLED OUT
				8 5/8"	350	-0-

Describe in detail the manner in which the well was plugged, indicating where the mud fluid was placed and the method or methods used in introducing it into the hole. If cement or other plugs were used, state the character of same and depth placed, from \_\_\_\_\_ feet to \_\_\_\_\_ feet for each plug set.

Plug set @ 300' w/40 sx  
Plug & bridge set @ 40' w/15 sx.

RECEIVED  
STATE CORPORATION COMMISSION  
FEB 13 1974  
CONSERVATION DIVISION  
Wichita, Kansas

(If additional description is necessary, use BACK of this sheet)  
Name of Plugging Contractor B & B Drilling, Inc.  
Address 720 Union Center, Wichita, Kansas

STATE OF Kansas, COUNTY OF Sedgwick, ss.  
Bill Lahar (employee of owner) or (owner or operator) of the above-described

well, being first duly sworn on oath, says: That I have knowledge of the facts, statements, and matters herein contained and the log of the above-described well as filed and that the same are true and correct. So help me God.

(Signature) Bill Lahar  
720 Union Center, Wichita, Kansas 67202  
(Address)

SUBSCRIBED AND SWORN TO before me this 11th day of February, 19 74

My commission expires January 29, 1977

Betty M. Maloney  
Notary Public.

February 11, 1974

DRILLERS LOG

#2-14 Conklin  
C NW/4  
Sec. 14-29S-17W  
Kiowa County, Kansas

OPERATOR: Marsh Oil & Associates  
CONTRACTOR: B & B Drilling, Inc.  
COMMENCED: February 5, 1974  
COMPLETED: February 9, 1974

8 5/8" @ 350' w/250 sx

0	60	Sand
60	535	Shale
535	976	Red Bed & Sand
976	995	Anhydrite
995	2020	Shale
2020	2250	Lime & Shale
2250	2900	Lime
2900		RTD

D & A

RECEIVED  
STATE CORPORATION COMMISSION  
FEB 13 1974  
CONSERVATION DIVISION  
Wichita, Kansas

We certify that the above and foregoing is a true and correct copy of the log on the #2-14 Conklin, located in Kiowa County, Kansas.

B & B DRILLING, INC.

Bill Lahar  
Bill Lahar

Subscribed and sworn to before me this 11th day of February, 1974.

Betty M. Maloney  
Betty M. Maloney Notary Public

My Commission Expires:

January 29, 1977