


STATE OF KANSAS
STATE CORPORATION COMMISSION

WELL PLUGGING RECORD

Give All Information Completely
Make Required Affidavit
Mail or Deliver Report to
Conservation Division
State Corporation Comm.
245 North Water
Wichita, KS 67202

KIOWA County. Sec. 32 Twp. 29SRge. 17 E/W
Location as "NE/CNW $\frac{1}{4}$ SW $\frac{1}{4}$ " or footage from lines _____

710 - ESL and 2310 FEL
Lease Owner TEXAS OIL AND GAS CORPORATION
Lease Name SCHWARM Well No. 1
Office Address 200 W DOUGLAS, SUITE 300, WICHITA, KS.
Character of Well (Completed as Oil, Gas or Dry Hole) _____

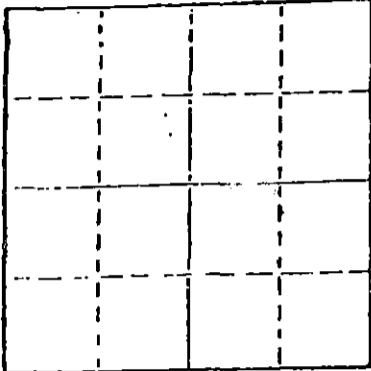

Locate well correctly on above
Section Plot

GAS
Date Well completed XX@K 8-29 1977
Application for plugging filed 11-10 1978
Application for plugging approved 11-15 1978
Plugging commenced 11-22 1978
Plugging completed 12- 4 1978
Reason for abandonment of well or producing formation _____

If a producing well is abandoned, date of last production _____ 19____

Was permission obtained from the Conservation Division or its agents before plugging was commenced? YES

Name of Conservation Agent who supervised plugging of this well BILL OWENS
Producing formation _____ Depth to top _____ Bottom _____ Total Depth of Well 4931
Show depth and thickness of all water, oil and gas formations.

OIL, GAS OR WATER RECORDS

CASING RECORD

FORMATION	CONTENT	FROM	TO	SIZE	PUT IN	PULLED OUT
				8 5/8	455	NONE
				5 1/2	4930	2629

Describe in detail the manner in which the well was plugged, indicating where the mud fluid was placed and the method or methods used in introducing it into the hold. If cement or other plugs were used, state the character of same and depth placed, from _____ feet to _____ feet for each plug set. BRIDGE PLUGGED AT 4897. Dumped sand from 4897 to 4850. DUMPED 4 sacks CEMENT FROM 4850 to 4830. Allied pumped surface. 3 sacks Hull - 20 sacks jel. 125 sacks 60 - 40 BOZ,

RECEIVED
STATE CORPORATION COMMISSION

DEC 28 1978

CONSERVATION DIVISION
Wichita, Kansas

12-28-78

(If additional description is necessary, use BACK of this sheet)

Name of Plugging Contractor CLARKE CORPORATION

STATE OF KANSAS COUNTY OF SEDGWICK, ss.


VICTOR C. SMITH of Texas Oil & Gas Corp. (employee of owner) or (owner or operator) of the above-described well, being first duly sworn on oath, says: That I have knowledge of the facts, statements, and matters herein contained and the log of the above-described well as filed and that the same are true and correct. So help me God.

(Signature) Victor C. Smith
VICTOR C. SMITH of Texas Oil & Gas Corp.
200 W. Douglas, (Address) Suite 300, Wichita, KS.

SUBSCRIBED AND SWORN TO before me this 27th day of December, 1978 KS 67202

Elizabeth A. Cauley
ELIZABETH A. CAULEY Notary Public.

My commission expires January 23, 1980

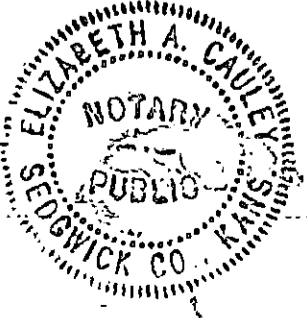

SCHWARM #1

710' FSL & 2310' FEL SEC 33-295-17W
KIOWA Co., Ks

8 5/8", 24", K-53 set @ 483' K.B.
w/375 SXS

RECEIVED
STATE CORPORATION COMMISSION

CMT TOP @ ± 4800' NOV 13 1978

CONSERVATION DIVISION
Wichita, Kansas

PERF
4882-88 w/4 JSFF

4877' PBD C.I.B.P.
PBD ± 4908' K.B.

149 JS, 4 1/2" 10.5", K-55
set @ 4930' K.B. w/100 SXS

