


STATE OF KANSAS  
STATE CORPORATION COMMISSION

Form CP-4

Give All Information Completely  
Make Required Affidavit  
Mail or Deliver Report to:  
Conservation Division  
State Corporation Commission

WELL PLUGGING RECORD

P. O. Box 17027  
Wichita, Kansas 67217

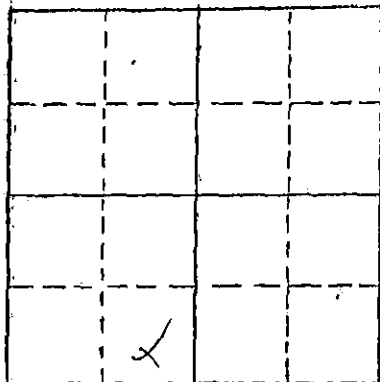

Locate well correctly on above  
Section Plat

Kiowa County, Sec 32 Twp 29 Rge 17 (E) W (W)  
Location as "NE/CNWSW" or footage from lines C SE SW  
Lease Owner Davies & Fitzgerald  
Lease Name Schwarm Well No # 2  
Office Address 1303 Philtower Bldg. ; Tulsa, Okla.  
Character of Well (completed as Oil, Gas or Dry Hole) \_\_\_\_\_  
Date well completed \_\_\_\_\_ 19\_\_\_\_  
Application for plugging filed April 1974  
Application for plugging approved April 1974  
Plugging commenced April 9 1974  
Plugging completed April 14 1974  
Reason for abandonment of well or producing formation \_\_\_\_\_

If a producing well is abandoned, date of last production \_\_\_\_\_ 19\_\_\_\_  
Was permission obtained from the Conservation Division or its agents before plugging was commenced? Yes

Name of Conservation Agent who supervised plugging of this well Russell Biberstein  
Producing formation \_\_\_\_\_ Depth to top \_\_\_\_\_ Bottom \_\_\_\_\_ Total Depth of Well \_\_\_\_\_ Feet  
Show depth and thickness of all water, oil and gas formations, \_\_\_\_\_

OIL, GAS OR WATER RECORDS

CASING RECORD

FORMATION	CONTENT	FROM	TO	SIZE	PUT IN	PULLED OUT
				8 5/8"	397	None
				5 1/2"	3144	1193

Describe in detail the manner in which the well was plugged, indicating where the mud fluid was placed and the method or methods used in introducing it into the hole. If cement or other plugs were used, state the character of same and depth placed, from \_\_\_\_\_ feet to \_\_\_\_\_ feet for each plug set.

April 9, 1974 Plugged off bottom. Dumped sand to 2800'. Mixed and dumped 5 sx of cement.  
April 14, 1974 Plugged off top. Allied Cementing Co. mixed and pumped down 8 5/8" surface casing, 2 sx of hulls, 10 sx of gel and 100 sx of cement.

RECEIVED  
STATE CORPORATION COMMISSION

MAY 24 1974

CONSERVATION DIVISION  
Wichita, Kansas

Name of Plugging Contractor, RUSS CASING PULLING, INC.  
Address P. O. Box 1082 ; Great Bend, Kansas 67530

STATE OF OKLAHOMA COUNTY OF TULSA ss.

David C. Davies (Operator) of the above-described well, being first duly sworn on oath, says: That I have knowledge of the facts, statements, and matters herein contained and the log of the above-described well as filed and that the same are true and correct. So help me God.

(Signature) David C. Davies David C. Davies  
1303 Philtower Bldg., Tulsa, Oklahoma 74103  
(Address)

Subscribed and Sworn to before me this 22nd day of May 1974

Cloris E. Smith  
Cloris E. Smith Notary Public

My commission expires October 19, 1976