

STATE OF KANSAS
STATE CORPORATION COMMISSION

Give All Information Completely
Make Required Affidavit
Mail or Deliver Report to:
Conservation Division
State Corporation Commission
212 North Market, Insurance Bldg.
Wichita, Kansas

12

WELL PLUGGING RECORD

Kiowa County, Sec. 32 Twp. 29 Rge. 17 (E) (W)

Location as "NE/CNW/SW" or footage from lines CSE SW

Lease Owner Herman George Kaiser

Lease Name Schwarm Well No. 1

Office Address Ellinwood, Kansas

Character of Well (completed as Oil, Gas or Dry Hole)

Date well completed 19

Application for plugging filed 19

Application for plugging approved 19


Plugging commenced 6-29 19 61

Plugging completed 7-3 19 61

Reason for abandonment of well or producing formation

If a producing well is abandoned, date of last production 19

Was permission obtained from the Conservation Division or its agents before plugging was commenced? Yes

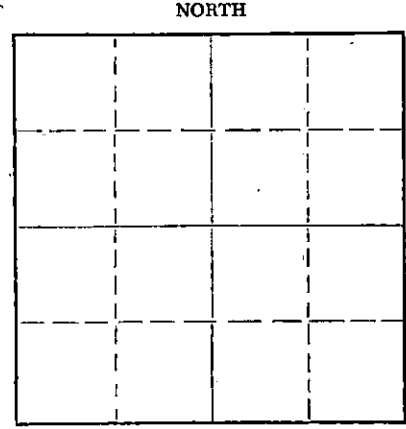

Locate well correctly on above Section Plat

Name of Conservation Agent who supervised plugging of this well Fred Hampel

Producing formation Depth to top Bottom Total Depth of Well 4863 Feet

Show depth and thickness of all water, oil and gas formations.

OIL, GAS OR WATER RECORDS

CASING RECORD

FORMATION	CONTENT	FROM	TO	SIZE	PUT IN	PULLED OUT
				8 5/8	399	None
				5 1/2	4860	3583'

Describe in detail the manner in which the well was plugged, indicating where the mud fluid was placed and the method or methods used in introducing it into the hole. If cement or other plugs were used, state the character of same and depth placed, from feet to feet for each plug set.

Top Perforation 4778

Bottom of hole squeezed with 50 sks cement through tubing to above perforations - pulled pipe - mudded to 250' - set 10' rock bridge - dumped 20 sks cement - mudded to 40' - set 10' rock bridge - dumped 10 sks cement

RECEIVED
STATE CORPORATION COMMISSION
JUL 13 1961
CONSERVATION DIVISION
Wichita, Kansas

Name of Plugging Contractor R & D Casing Pulling Co. License # 236
Address Box # 372, Hutchinson, Kansas

STATE OF KANSAS, COUNTY OF BARTON, ss.

(employee of owner) or (owner or operator) of the above-described well, being first duly sworn on oath, says: That I have knowledge of the facts, statements, and matters herein contained and the log of the above-described well as filed and that the same are true and correct. So help me God.

(Signature) [Signature]
(Address)

SUBSCRIBED AND SWORN TO before me this 11 day of July, 1961

Evelyn A Miller
Notary Public.

My commission expires FEB 25, 1963

INVOICED

DATE 7/18/61
INV. NO. 3380-u