


STATE OF KANSAS
STATE CORPORATION COMMISSION

WELL PLUGGING RECORD

Give All Information Completely
Make Required Affidavit
Mail or Deliver Report to
Conservation Division
State Corporation Comm.
245 North Water
Wichita, KS 67202

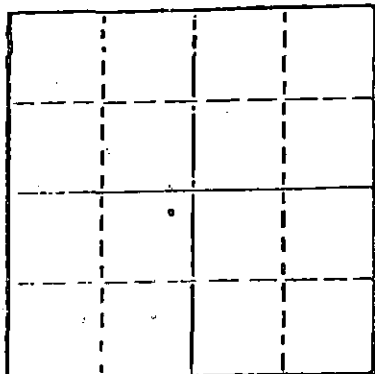

Locate well correctly on above
Section Plat

KIOWA County. Sec. 32 Twp. 29S Rge. 17 ~~W~~
Location as "NE/CNW $\frac{1}{4}$ SW $\frac{1}{4}$ " or footage from lines
790' FSL & 660' FWL
Lease Owner Texas Oil & Gas Corp.
Lease Name SCHWARM Well No. 2
Office Address 200 W. Douglas, Suite 300, Wichita, KS. 67202
Character of Well (Completed as Oil, Gas or Dry Hole) Dry Hole
Date Well completed 12-11-77 19
Application for plugging filed 12-11-77 19
Application for plugging approved 12-11-77 19
Plugging commenced 12-11-77 19
Plugging completed 12-11-77 19
Reason for abandonment of well or producing formation

If a producing well is abandoned, date of last production 19

Was permission obtained from the Conservation Division or its agents before plugging was commenced? Yes

Name of Conservation Agent who supervised plugging of this well William Owens
Producing formation _____ Depth to top _____ Bottom _____ Total Depth of Well 4881
Show depth and thickness of all water, oil and gas formations.

OIL, GAS OR WATER RECORDS

CASING RECORD

FORMATION	CONTENT	FROM	TO	SIZE	PUT IN	PULLED OUT
		0	460	8 5/8"		

Describe in detail the manner in which the well was plugged, indicating where the mud fluid was placed and the method or methods used in introducing it into the hold. If cement or other plugs were used, state the character of same and depth placed, from _____ feet to _____ feet for each plug set.

Plug. Heavy mud T.D. to 460' 40 sack cement plug mud
40' 1/2 sack hulls plug bridge 12 sacks base cellar
3 sacks rat hole. By Allied.

RECEIVED
STATE CORPORATION COMMISSION

DEC 19 1977

CONSERVATION DIVISION
Wichita, Kansas

(If additional description is necessary, use BACK of this sheet)

Name of Plugging Contractor Xplor Drilling Co.
453 S. Webb Rd. Wichita, KS 67207

STATE OF KANSAS COUNTY OF SEDGWICK, ss.


Kirby C. Evers (employee of owner) or (~~owner or operator~~)
of the above-described well, being first duly sworn on oath, says: That I have knowledge of the facts, statements, and matters herein contained and the log of the above-described well as filed and that the same are true and correct. So help me God.

(Signature) Kirby C. Evers
453 S. Webb Rd., Wichita KS 67207
(Address)

SUBSCRIBED AND SWORN TO before me this 13 day of December, 1977

Virginia Lee Smith
Virginia Lee Smith Notary Public.

My commission expires August 25, 1980

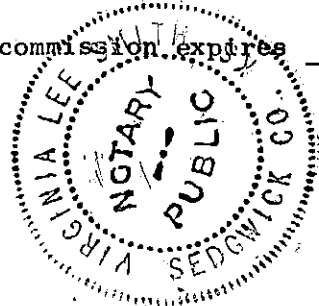

WELL LOG

COPY

SCHWARM #2
 790' FSL & 660' FWL
 Section 32-29S-17W
 Kiowa County, Kansas

OPERATOR: TEXAS OIL & GAS CORP. COMMENCED: 11-30-77
 CONTRACTOR: XPLOR DRILLING CO. COMPLETED: 12-11-77

CASING RECORD: Ran 11 jts. new 8 5/8" 24# set @460', cement with 450 sacks cement, 300 sacks Light Weight, 150 sacks Class H 3% cal. chloride, 2% gel. By Allied. Cement Circulated.

<u>FORMATION</u>	<u>FROM</u>	<u>TO</u>	<u>ELEVATION</u>
Sand	0	460	2027 Gr
Red Bed	460	610	2032 D.F.
Red Bed & Lime	610	2210	2035 K.B.
Lime & Shale	2210	2710	
Lime	2710	4881	
R.T.D.	4881		

RECEIVED
 STATE CORPORATION COMMISSION
 DEC 14 1977
 CONSERVATION DIVISION
 Wichita, Kansas

STATE OF KANSAS)
) SS:
 COUNTY OF SEDGWICK)

I certify that this is a true and correct copy of the Driller's Log of the well drilled 790' FSL & 660' FWL of Section 32-29S-17W, Kiowa County, Kansas, to the best of my knowledge and belief.

XPLOR DRILLING COMPANY

Kirby C. Evers
 Kirby C. Evers, Vice-President

Subscribed and sworn to before me this 13th. day of December, 1977.

MY COMMISSION EXPIRES:
 August 25, 1980

Virginia Lee Smith
 Virginia Lee Smith, Notary Public

