15-097-20144-0000

STATE OF KANSAS
STATE CORPORATION COMMISSION

Give All Information Completely
Make Required Affidavit
Mail or Deliver Report to
Conservation Division
State Corporation Commission
P. O. Box 17027
Wichita, Kansas 67217

Form CP-4

WELL PLUGGING RECORD

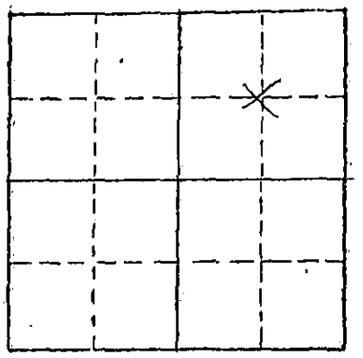

Locate well correctly on above Section Plat

Kiowa County. Sec. 33 Twp. 29 Rge. 17 (E) W (W)
Location as "NE/CNWSWE" or footage from lines C NE/4
Lease Owner Davies & Fitzgerald
Lease Name Koehn Well No. #1
Office Address 1303 Philtower Bldg. : Tulsa, Okla.
Character of Well (completed as Oil, Gas or Dry Hole)
Date well completed 19
Application for plugging filed April 19 74
Application for plugging approved April 19 74
Plugging commenced April 4 19 74
Plugging completed April 19 19 74
Reason for abandonment of well or producing formation

If a producing well is abandoned, date of last production 19
Was permission obtained from the Conservation Division or its agents before plugging was commenced? Yes
Name of Conservation Agent who supervised plugging of this well Russell Biberstein
Producing formation Depth to top Bottom Total Depth of Well Feet
Show depth and thickness of all water, oil and gas formations.

OIL, GAS OR WATER RECORDS

CASING RECORD

FORMATION	CONTENT	FROM	TO	SIZE	PUT IN	PULLED OUT
				8 5/8"	438	None
				5 1/2"	3735	2101

Describe in detail the manner in which the well was plugged, indicating where the mud fluid was placed and the method or methods used in introducing it into the hole. If cement or other plugs were used, state the character of same and depth placed, from feet to feet for each plug set.

April 4, 1974 Plugged off bottom. Dumped sand to 2450'. Mixed and dumped 5 sx of cement.

April 19, 1974 Plugged off top. Allied Cementing Co. mixed and pumped down 8 5/8" surface casing, 2 sx of hulls, 10 sx of gel and 100 sx of cement.

RECEIVED
STATE CORPORATION COMMISSION
MAY 24 1974
CONSERVATION DIVISION
Wichita, Kansas

(If additional description is necessary, use BACK of this sheet)

Name of Plugging Contractor RUSS CASING PULLING, INC.
Address P. O. Box 1082 : Great Bend, Kansas 67530

STATE OF OKLAHOMA, COUNTY OF TULSA, ss.
David C. Davies (~~owner~~ operator) of the above-described well, being first duly sworn on oath, says: That I have knowledge of the facts, statements, and matters herein contained and the log of the above-described well as filed and that the same are true and correct. So help me ~~God~~.

(Signature) David C. Davies
1303 Philtower Bldg., Tulsa, Okla. 74103
(Address)

SUBSCRIBED AND SWORN TO before me this 22 day of May, 19 74

My commission expires October 19, 1976

Cloris E. Smith
Notary Public.

15-097-20144-0000

GABBERT-JONES, INC.
WICHITA, KANSAS
DRILLERS' WELL LOG

KOEHN #1
C NE/4
Sec. 33-29S-17W
Kiowa County, Kansas

Commenced: November 3, 1972
Completed: November 16, 1972

RECEIVED
STATE CORPORATION COMMISSION
OCT 15 1973
CONSERVATION DIVISION
Wichita, Kansas

OPERATOR: DAVIES & FITZGERALD

Depth From	Depth To	Formation	Remarks
0	438	Clay	Ran 10 joints of used 28# 8 5/8"
438	530	Redbed and shale	csg. set @ 434' cemented w/300 sks
530	1058	Redbed-shale-shells	common, 3% Gel, 3% CC
1058	1230	Anhydrite and salt	P.D. @ 3:45 AM 11/4/72
1230	2250	Shale-shells	Cement Circ.
2250	2405	Shale-lime	Centralizer @ 415'
2405	3425	Lime-shale	
3425	3755	Lime	
3755	3940	Lime-shale	
3940	4060	Lime	
4060	4340	Lime and shale	
4340	4915	Lime	
4915	TD		Ran 112 jts of 15 1/2# & 14# 8 Round 5 1/2" csg. set @ 3735' cemented w/250 sks 50/50 Posmix 18% Salt, 12 1/2# Gilsonite per sack, 2% Gel - 1% CFR2 Float @ 3700' P.D. @ 7 PM 11/16/1972

I, James S. Sutton, II, certify this is a correct copy of the drillers' log for the well drilled in the C NE/4, Section 33-29S-17W, Kiowa County, Kansas, to thebest of my knowledge and belief.

James S. Sutton, II

STATE OF KANSAS)
) SS
COUNTY OF SEDGWICK)

Before me, the undersigned, a Notary Public within and for said county and State, on this 20th day of November, 1972, personally appeared James S. Sutton, II, to me personally known to be the identical person who executed the within and foregoing instrument and acknowledged to me that he executed the same as his free and voluntary act and deed for the uses and purposes therein set forth.

IN WITNESS WHEREOF, I have hereunto set my hand and official seal the day and year last above written.

Marjorie Hall, Notary Public

My commission expires
November 29, 1975