


STATE OF KANSAS
STATE CORPORATION COMMISSION

WELL PLUGGING RECORD

Give All Information Completely
Make Required Affidavit
Mail or Deliver Report to
Conservation Division
State Corporation Comm.
245 North Water
Wichita, KS 67202

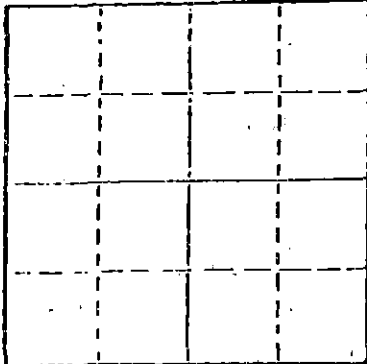

Locate well correctly on above
Section Plot

Kiowa County, Sec. 36 Twp. 29 Rge. 17 E/W

Location as "NE/CNW $\frac{1}{4}$ SW $\frac{1}{4}$ " or footage from lines

C SW NW 1980 FNL & 66 FWL

Lease Owner M & F Oil

Lease Name Pratt County Library Well No. #1

Office Address 422 Union Center, Wichita, Kansas 67202

Character of Well (Completed as Oil, Gas or Dry Hole)

Dry Hole

Date Well completed September 2 1981

Application for plugging filed September 2 1981

Application for plugging approved September 2 1981

Plugging commenced September 2 1981

Plugging completed September 2 1981

Reason for abandonment of well or producing formation

D & A

If a producing well is abandoned, date of last production 19.

Was permission obtained from the Conservation Division or its agents before plugging was commenced? yes

Name of Conservation Agent who supervised plugging of this well Maurice Leslie

Producing formation Depth to top Bottom Total Depth of Well 4865

Show depth and thickness of all water, oil and gas formations.

OIL, GAS OR WATER RECORDS

CASING RECORD

FORMATION	CONTENT	FROM	TO	SIZE	PUT IN	PULLED OUT
				8 5/8	414	none

Describe in detail the manner in which the well was plugged, indicating where the mud fluid was placed and the method or methods used in introducing it into the hold. If cement or other plugs were used, state the character of same and depth placed, from feet to feet for each plug set.

620 Ft. 60 sx

390 Ft. 50 sx

40 Ft. plug & 10 sx

10 sx Rathole

50/50 poz

4% Gel 3%cc

9-11-81

RECEIVED
STATE CORPORATION COMMISSION

(If additional description is necessary, use BACK of this sheet) 11 1981

Name of Plugging Contractor Mustang Drilling & Exploration, Inc.

CONSERVATION DIVISION
Wichita, Kansas


STATE OF Kansas COUNTY OF Barton, ss.
Milford Martin (employee of owner) or (owner or operator)
of the above-described well, being first duly sworn on oath, says: That I have knowledge of the facts, statements, and matters herein contained and the log of the above-described well as filed and that the same are true and correct. So help me God.

(Signature)

P.O. Box 1609, Great Bend, Kansas 67530
(Address)

SUBSCRIBED AND SWORN TO before me this 4th day of September, 1981

My commission expires

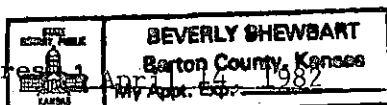

Beverly Shewbart
Notary Public.

OPERATOR: F & M Oil Company
422 Union Center Building, Wichita, Kansas 67202

WELL: Pratt County Library No. 1

API # 15-097-20,798

LOCATION: 1980 FNL & 660 FWL NW/4

Sec 36-T 29 S-R 17 Kiowa County

COMMENCED: August 24, 1981

COMPLETED: September 2, 1981

ELEVATION: GL: 2030 DF: 2037 KB: 2040

TOTAL DEPTH: 4865

CASING: Surface: 8 5/8"; 24 #; set at 414 feet;
Cemented with 325 sacks Common cement; 2% gel; 3% cc

Production: ; #; set at feet;
Cemented with sacks cement;

DEPTH:	FORMATION	FORMATION TOPS (sample)
0 - 420	Sand, Shale	Krider 2400
420 - 1470	Sand, Shale, Lime	Winfield 2436
1470 - 2400	Lime, Shale	Towanda 2496
2400 - 2550	lime	Ft. Riley 2546
2550 - 2650	Chert, Lime	Base Florence 2628
2650 - 3700	Lime, Shale	Wreford 2696
3700 - 4024	Lime	Council Grove 2726
4024 - 4030	Shale	Cottonwood 2878
4030 - 4088	Lime	Oreace 3907
4088 - 4184	Shale	Heebner 4024
4184 - 4550	Lime	Douglas 4088
4550 - 4731	Lime, Shale	Brown Lime 4184
4731 - 4771	Shale	Lansing 4203
4771 - 4783	Sand	Base KC 4549
4783 - 4847	Chert	Marmaton 4563
4847 - 4865	Lime	Cherokee Shale 4731
		Cherokee Sand 4771
		Mississippian 4783
		Mississippian
		Lime 4847
		RTD 4865

RECEIVED
STATE CORPORATION COMMISSION

SEP 11 1981

ACKNOWLEDGEMENT

CONSERVATION DIVISION
Wichita, Kansas

STATE OF KANSAS, COUNTY OF BARTON, ss:

Before me, the undersigned, a Notary Public, within and for said county and state, on this 9th day of September, 1981, personally appeared William Nelson to me personally known to be the identical person who executed the within and foregoing instrument and acknowledged to me that he executed the same as his free and voluntary deed for the uses and purposes therein set forth.

Subscribed and sworn to before me this 9th day of September, 1981.

My Appointment Expires: 4-14-82
BEVERLY SHEWBART
Notary Public
Barton County, Kansas
My App. Exp. 4-14-82

William Nelson
Notary Public