

STATE OF KANSAS
STATE CORPORATION COMMISSION

WELL PLUGGING RECORD

Give All Information Completely
Make Required Affidavit
Mail or Deliver Report to:
Conservation Division
State Corporation Commission
212 No. Market
Wichita, Kansas

County. Sec. 6 Twp. 29 Rge. 17 (E) (W)

Location as "NE/CNWSW" or footage from lines. NW-NW-40-NW

Lease Owner Petrodynamics, Inc.

Lease Name Kruse Well No. 1

Office Address P. O. Box 10006 Amarillo, Texas

Character of Well (completed as Oil, Gas or Dry Hole) Gas

Date well completed 12-6 19 63

Application for plugging filed 8-5 19 70

Application for plugging approved 8-5 19 70


Plugging commenced 8-6 19 70

Plugging completed 8-7 19 70

Reason for abandonment of well or producing formation Well too small to produce

If a producing well is abandoned, date of last production Never Produced 19

Was permission obtained from the Conservation Division or its agents before plugging was commenced? Yes

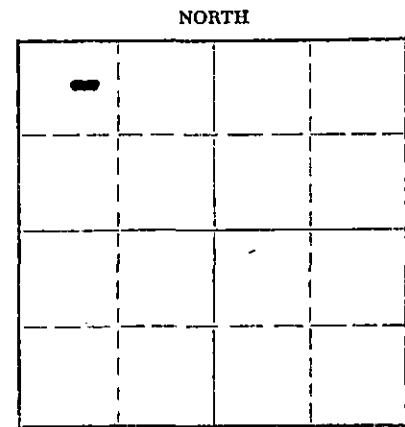

Locate well correctly on above Section Plat

Name of Conservation Agent who supervised plugging of this well G. R. Biberstein

Producing formation Mississippi Depth to top 4896 Bottom 4910 Total Depth of Well 5080 Feet

Show depth and thickness of all water, oil and gas formations.

OIL, GAS OR WATER RECORDS

CASING RECORD

FORMATION	CONTENT	FROM	TD	SIZE	PUT IN	PULLED OUT
Mississippi	Gas	4896	4902	4 1/2	5080	1807
				8 5/8	427	-0-

Describe in detail the manner in which the well was plugged, indicating where the mud fluid was placed and the method or methods used in introducing it into the hole. If cement or other plugs were used, state the character of same and depth placed, from feet to feet for each plug set.

Mixed and pumped 25 sacks cement from 3180' to 3480', Spotted 50 sacks cement from 453' to 303', Ran 10 sacks cement from 4' to 34.

RECEIVED
STATE CORPORATION COMMISSION
AUG 17 1970
CONSERVATION DIVISION
Wichita, Kansas

(If additional description is necessary, use BACK of this sheet)

Name of Plugging Contractor Daco Lease & Well Service
Address 1700 South Main Borger, Texas 79007

STATE OF Texas, COUNTY OF Hutchinson, ss. J. L. Martin Jr.

(employee of owner) or (~~owner or operator~~) of the above-described well, being first duly sworn on oath, says: That I have knowledge of the facts, statements, and matters herein contained and the log of the above-described well as filed and that the same are true and correct. So help me God.

(Signature) J. L. Martin Jr.
827 Latimer Borger, Texas
(Address)

SUBSCRIBED AND SWORN TO before me this 14 day of August 19 70

My commission expires June 1, 1971

Sharon Shelton
Notary Public.