


STATE OF KANSAS
STATE CORPORATION COMMISSION

WELL PLUGGING RECORD

Give All Information Completely
Make Required Affidavit
Mail or Deliver Report to
Conservation Division
State Corporation Comm.
245 North Water
Wichita, KS 67202

Kiowa County, Sec. 10 Twp. 29S Rge. 17W E/W
Location as "NE/CNW $\frac{1}{4}$ SW $\frac{1}{4}$ " or footage from lines
SW SE SE

Lease Owner Wenert Trich Oil & Gas
Lease Name Conklin Well No. 1
Office Address P. O. Box 1408, Longview, TX 75606
Character of Well (Completed as Oil, Gas or Dry Hole) Dry Hole

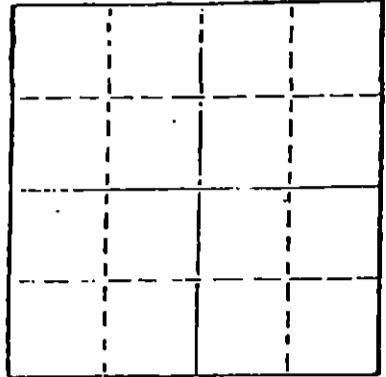

Locate well correctly on above
Section Plot

Date Well completed 10-5-83 19
Application for plugging filed 10-31-83 19
Application for plugging approved 10-5-83 19
Plugging commenced 10-5-83 19
Plugging completed 10-5-83 19
Reason for abandonment of well or producing formation Dry & Abandoned

If a producing well is abandoned, date of last production 19

Was permission obtained from the Conservation Division or its agents before plugging was commenced? Yes

Name of Conservation Agent who supervised plugging of this well Richard Lacy
Producing formation _____ Depth to top _____ Bottom _____ Total Depth of Well _____
Show depth and thickness of all water, oil and gas formations.

OIL, GAS OR WATER RECORDS

CASING RECORD

FORMATION	CONTENT	FROM	TO	SIZE	PUT IN	PULLED OUT

Describe in detail the manner in which the well was plugged, indicating where the mud fluid was placed and the method or methods used in introducing it into the hold. If cement or other plugs were used, state the character of same and depth placed, from _____ feet to _____ feet for each plug set.

- 1st plug at 900' with 50 sacks
- 2nd plug at 480' with 40 sacks
- 3rd plug at 40' with 10 sacks
- 10 sacks in rat hole
- 5 Sacks in the water well.

(If additional description is necessary, use BACK of this sheet)

Name of Plugging Contractor Gabbert-Jones, Inc.

STATE OF Texas COUNTY OF Gregg, ss.

James N. Trich (employee of owner) or (~~owner or operator~~)
of the above-described well, being first duly sworn on oath, says: That I have knowledge of the facts, statements, and matters herein contained and the log of the above-described well as filed and that the same are true and correct. So help me God.

(Signature) James N. Trich
P. O. Box 1408, Longview, TX 75606
(Address)

SUBSCRIBED AND SWORN TO before me this 3rd day of November, 1983

My commission expires 6-11-86

Jill Marie Smith
Notary Public
JILL MARIE SMITH

RECEIVED
STATE CORPORATION COMMISSION

NOV 8 1983