

STATE OF KANSAS
STATE CORPORATION COMMISSION


Give All Information Completely
Make Required Affidavit
Mail or Deliver Report to:
Conservation Division
State Corporation Commission
800 Bittling Building
Wichita, Kansas

WELL PLUGGING RECORD

Kiowa County, Sec. 11 Twp. 29 Rge. 17 (E) 17 (W)

Location as "NE/CNW%SW%" or footage from lines SW SW SW
Lease Owner Barbara Oil Company
Lease Name Conklin Well No. 1
Office Address 322 Central Building, Wichita 2, Kansas
Character of Well (completed as Oil, Gas or Dry Hole) D&A
Date well completed May 17, 1955 19
Application for plugging filed May 17, 1955 19
Application for plugging approved Verbally May 17, 1955 19
Plugging commenced May 17, 1955 19
Plugging completed May 17, 1955 19
Reason for abandonment of well or producing formation D&A

NORTH

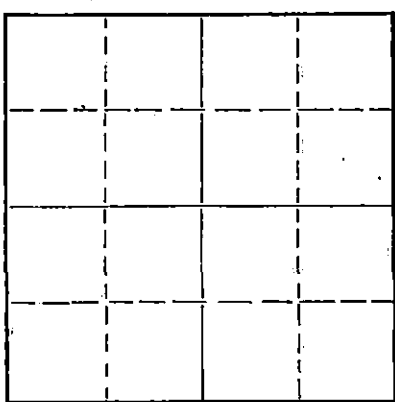

Locate well correctly on above
Section Flat

If a producing well is abandoned, date of last production 19
Was permission obtained from the Conservation Division or its agents before plugging was commenced? Yes verbally

Name of Conservation Agent who supervised plugging of this well M.A. Rives
Producing formation _____ Depth to top _____ Bottom _____ Total Depth of Well _____ Feet
Show depth and thickness of all water, oil and gas formations.

OIL, GAS OR WATER RECORDS

CASING RECORD

FORMATION	CONTENT	FROM	TO	SIZE	PUT IN	PULLED OUT
				13"	152	None

Describe in detail the manner in which the well was plugged, indicating where the mud fluid was placed and the method or methods used in introducing it into the hole. If cement or other plugs were used, state the character of same and depth placed, from _____ feet to _____ feet for each plug set.

Halliburton bridge plug set at 150', ran 25 sack cement on top of plug through drill pipe to 20' from surface, set Halliburton plug at 20', added 1 sack hulls and filled to surface with cement.

(If additional description is necessary, use BACK of this sheet)
Name of Plugging Contractor R.C. Patton Company
Address Orpheum Bldg., Wichita, Kansas

STATE OF Kansas COUNTY OF Sedgwick, ss.
R.F. Ramsey (employee of owner) or (owner or operator) of the above-described well, being first duly sworn on oath, says: That I have knowledge of the facts, statements, and matters herein contained and the log of the above-described well as filed and that the same are true and correct. So help me God.

(Signature) R.F. Ramsey
322 Central Building, Wichita, Kansas
(Address)

SUBSCRIBED AND SWORN TO before me this 18th day of May, 1955

My commission expires March 2, 1957

Walter P. Fisher Notary Public.

RECEIVED
STATE CORPORATION COMMISSION

MAY 19 1955

PLUGGING
FILED SEC 11 T 29 R 17 W
MAY 19 1955
WICHITA, KANSAS

CONSERVATION DIVISION
Wichita, Kansas

Esperanza Oil Company
Conklin Well # 1
Total Depth
Comm:
Comp.
Contractor R. C. Patton Co.,

Location; SW/4, SW/4, SW/4, Section
11-T29S-R17W Kiowa County, Kansas.
CASING RECORD.
13" O.D. Casing at 155 Feet
Cemented with 150 Sacks Cement

5125'
4/22/55
5/18/55

Sand	55
Gray Shale	70
Sand	85
Gray Shale	225
Red Shale	365
Anhydrite	375
Shale & Shells	945
Anhydrite & Shale	960
Shale & Shells	1150
Salt & Shale	1190
Shale & Shells	2120
Lime & Shale	3395
Lime	3432
Lime & Shale	3818
Lime	3904
Lime & Shale	4110
Sand & Lime	4126
Lime & Shale	4188
Lime	4494
Lime & Shale	4698
Lime Cherty	4775
Lime & Shale	4795
Lime	4813
Shale, Chert & Sand	4843
Shale, Lime & Chert	4865
Lime Cherty	5006
Dolomite	5023
Lime & Shale	5098
Lime	5125
Total Depth	5125

TOPS: from Kelly Bushing

Heebner	3964'
Brown Lime	4130
Lens. K.C.	4144
Mississippian	4700
Kinderhook Shale	4803
Viola	4857
Simpson Dol.	5005
Simpson Shale	5022
Arbuckle	5090

STATE OF Kansas COUNTY OF Sedgewick ss.

I, the undersigned, being duly sworn, on oath state that the above statement and log is a true and correct record and log of the well drilled at the location above described.

R. C. PATTON CO.,

By Robert W. Patton

Subscribed and sworn to before me this 21st day of May 1955

R. P. Windrich
Notary Public.

My Commission Expires Oct 4th 1956.

RECEIVED
STATE CORPORATION COMMISSION
MAY 24 1955
CONSERVATION DIVISION
Wichita, Kansas

PLUGGING
FILE SEC 11 T 29 R 17W
BOOK PAGE 119 LINE 32