


STATE OF KANSAS
STATE CORPORATION COMMISSION

Form CP-4

Give All Information Completely
Make Required Affidavit
Mail or Deliver Report to:
Conservation Division
State Corporation Commission
211 No. Broadway
Wichita, Kansas

WELL PLUGGING RECORD

NORTH

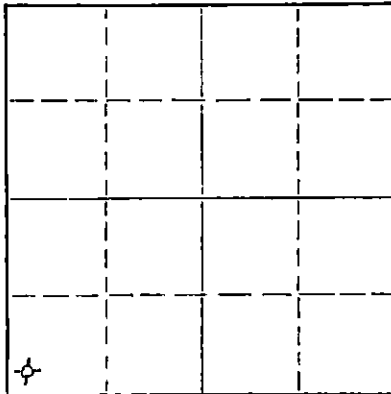

Locate well correctly on above
Section Plat

Kiowa County. Sec. 11 Twp. 29S Rge. 17W (E) (W)
Location as "NE/CNW/SW" or footage from lines. 330' FS & WL
Lease Owner Uas. F. Smith
Lease Name Conklin Well No. 1
Office Address Box 10005, Amarillo, Texas
Character of Well (completed as Oil, Gas or Dry Hole) Oil
Date well completed February 7, 1964
Application for plugging filed January 3, 1967
Application for plugging approved January 5, 1967
Plugging commenced January 29, 1967
Plugging completed January 29, 1967
Reason for abandonment of well or producing formation Non-commercial

If a producing well is abandoned, date of last production 12-31 1966
Was permission obtained from the Conservation Division or its agents before plugging was commenced? yes

Name of Conservation Agent who supervised plugging of this well A. Elving
Producing formation Mississippian Depth to top 4694 Bottom 4737 Total Depth of Well 5030 Feet
Show depth and thickness of all water, oil and gas formations. Plugged back T.D. 4760'

OIL, GAS OR WATER RECORDS

CASING RECORD

FORMATION	CONTENT	FROM	TO	SIZE	PUT IN	PULLED OUT
Mississippian	oil	4694	4737	13"	152'	0
				4-1/2"	5030'	2542'

Describe in detail the manner in which the well was plugged, indicating where the mud fluid was placed and the method or methods used in introducing it into the hole. If cement or other plugs were used, state the character of same and depth placed, from _____ feet to _____ feet for each plug set.

Mixed and pumped 25 sacks cement with plug to 4520'.
Filled hole with mud to 320', spotted 70 sacks cement from 320' to 220'.
Filled hole with 50 sacks cement from 220' to 120'. Filled hole with mud to 28'. Spotted 25 sacks cement from 28' to 4'. Welded cap on top.

STATE CORPORATION COMMISSION
FEB 17 1967

CONSERVATION DIVISION
Wichita, Kansas

2-17-67

(If additional description is necessary, use BACK of this sheet)

Name of Plugging Contractor Daco Lease & Well Service, 1700 South Main, Borger, Texas 79007
Address _____

STATE OF Texas, COUNTY OF Potter, ss.
Mark Williams (employee of owner) or (owner or operator) of the above-described well, being first duly sworn on oath, says: That I have knowledge of the facts, statements, and matters herein contained and the log of the above-described well as filed and that the same are true and correct. So Help me God.

(Signature)

P. O. Box 10,005, Amarillo, Texas
(Address)

SUBSCRIBED AND SWORN TO before me this 14th day of February, 1967

Carol Hodges

Carol Hodges
Notary Public.

My commission expires June 1, 1967.