


STATE OF KANSAS
STATE CORPORATION COMMISSION

Give All Information Completely
Make Required Affidavit
Mail or Deliver Report to:
Conservation Division
State Corporation Commission
212 North Market, Insurance Bldg.
Wichita, Kansas

WELL PLUGGING RECORD

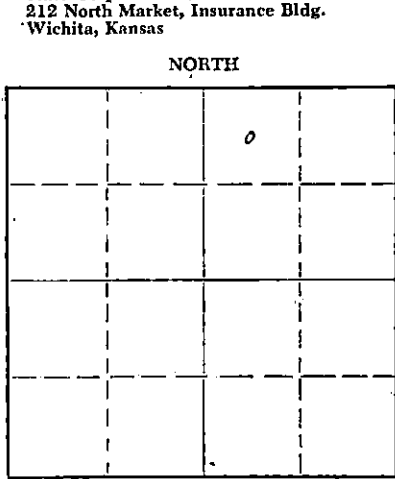

Locate well correctly on above
Section Plat

Kiowa

County. Sec. 22 Twp. 29S Rge. 17W (E) (W)

Location as "NE/CNW/SW" or footage from lines ~~0 NW NE NENE NW~~

Lease Owner Sunray Mid-Continent Oil Company

Lease Name Richard Robbins Well No. 1

Office Address Box 1878 - Wichita, Kansas

Character of Well (completed as Oil, Gas or Dry Hole) Dry Hole

Date well completed November 1, 19 59

Application for plugging filed November 3, 19 59

Application for plugging approved November 4, 19 59

Plugging commenced November 4, 19 59

Plugging completed November 9, 19 59

Reason for abandonment of well or producing formation Dry Hole

If a producing well is abandoned, date of last production 19

Was permission obtained from the Conservation Division or its agents before plugging was commenced? Yes

Name of Conservation Agent who supervised plugging of this well Mr. W. L. Jackamp

Producing formation Dry Depth to top Bottom Total Depth of Well 4795 Feet

Show depth and thickness of all water, oil and gas formations.

OIL, GAS OR WATER RECORDS

CASING RECORD

FORMATION	CONTENT	FROM	TO	SIZE	PUT IN	PULLED OUT
Mississippi	Water	4736'	4795'	8-5/8"	408'	0

Describe in detail the manner in which the well was plugged, indicating where the mud fluid was placed and the method or methods used in introducing it into the hole. If cement or other plugs were used, state the character of same and depth placed, from feet to feet for each plug set.

Filled hole with drilling mud and kept hole full until settling stopped.
Ten sack cement plug placed at the surface. Steel plate welded over surface pipe.

RECEIVED
STATE CORPORATION COMMISSION
DEC 8 1959
CONSERVATION DIVISION
Wichita, Kansas

(If additional description is necessary, use BACK of this sheet)

Name of Plugging Contractor Stickle Drilling Company & Halliburton

Address Tulsa, Oklahoma

STATE OF Kansas, COUNTY OF Sedgwick, ss.
Nash A. Gough (employee of owner) ~~known to operator~~ of the above-described well, being first duly sworn on oath, says: That I have knowledge of the facts, statements, and matters herein contained and the log of the above-described well as filed and that the same are true and correct. So help me God.

(Signature) Nash A. Gough
Box 1878 - Wichita, Kansas
(Address)

SUBSCRIBED AND SWORN TO before me this 10th day of November, 19 59

My commission expires July 13, 1963

W. L. Jackamp
Notary Public.

Sunray Mid-Continent Oil Company
Tulsa, Oklahoma

Tulsa, Oklahoma
November 4, 1959

CONTRACTOR: Stickle Drilling Company
Drilling Commenced: October 21, 1959
Drilling Completed: November 1, 1959

Richard W. Robbins #1 C. *NENE NW*
of ~~NW/4 NE/4~~ Sec. 22-29S-
17W, Kiowa County, Kansas.

DRILLERS LOG

Total Depth Figures Indicate Base of Formation:

Surface	0
Shale & Shells	150
Shale & Red Bed	346
Anhydrite	371
Red Bed & Shale	1025
Shale & Shells	1310
Shale & Salt	1400
Shale & Shells	2225
Lime & Shale	2345
Lime	2510
Lime & Shale	2645
Lime	2785
Lime & Shale	2900
Shale & Lime	3825
Lime & Shale	4005
Shale & Lime	4170
Lime	4320
Lime & Chert	4343
Lime	4653
Lime & Shale	4710
Lime & Chert	4795 TD

RECEIVED
STATE CORPORATION COMMISSION
DEC 8 1959
CONSERVATION DIVISION
Wichita, Kansas

I, Fred E. Stickle hereby certify the above to be a true and complete
Drillers Log of Sunray Mid-Continent Oil Company's Richard E. Robbins
#1 C. of NW/4 NE/4 Section 22-29S-17W, Kiowa County, Kansas.

Fred E. Stickle
Fred E. Stickle

Lillian T. Bonham
Notary Public

February 13, 1960
My Commission Expires