

Give All Information Completely  
Make Required Affidavit  
Mail or Deliver Report to:  
Conservation Division  
State Corporation Commission  
212 No. Market  
Wichita, Kansas

WELL PLUGGING RECORD

Kiowa County, Sec. 22 Twp. 29 Rge. 17 (E) (W)

Location as "NE/CNW/SW" or footage from lines C NE of NW

Lease Owner Petrodynamics, Inc.

Lease Name Robbins Well No. 1-22

Office Address P. O. Box 10006 Amarillo, Texas

Character of Well (completed as Oil, Gas or Dry Hole) Gas

Date well completed 12-3 19 63

Application for plugging filed 8-5 19 70

Application for plugging approved 8-5 19 70


Plugging commenced 8-8 19 70

Plugging completed 8-9 19 70

Reason for abandonment of well or producing formation Well to small to produce

If a producing well is abandoned, date of last production Never produced 19

Was permission obtained from the Conservation Division or its agents before plugging was commenced? Yes

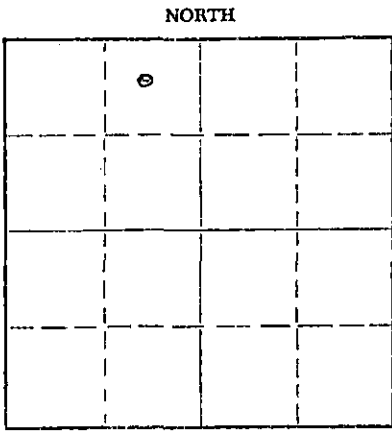

Locate well correctly on above Section Plat

Name of Conservation Agent who supervised plugging of this well G. R. Biberstein

Producing formation Mississippi Depth to top 4735 Bottom 4755 Total Depth of Well 4791 Feet

Show depth and thickness of all water, oil and gas formations.

OIL, GAS OR WATER RECORDS

CASING RECORD

FORMATION	CONTENT	FROM	TO	SIZE	PUT IN	PULLED OUT
Mississippi	Gas	4740	4750	4 1/2	4791	1925
				8 5/8	408	-0-

Describe in detail the manner in which the well was plugged, indicating where the mud fluid was placed and the method or methods used in introducing it into the hole. If cement or other plugs were used, state the character of same and depth placed, from \_\_\_\_\_ feet to \_\_\_\_\_ feet for each plug set.

Mixed and pumped 25 sacks cement from 3621' to 3921', Spotted 50 sacks cement from 458' to 308', Ran 10 sacks cement from 4' to 34'.

RECEIVED  
STATE CORPORATION COMMISSION  
AUG 17 1970  
CONSERVATION DIVISION  
Wichita, Kansas

(If additional description is necessary, use BACK of this sheet)

Name of Plugging Contractor Daco Lease & Well Service  
Address 1700 South Main Borger, Texas 79007

STATE OF Texas, COUNTY OF Hutchinson, ss.  
J. L. Martin Jr. (employee of owner) or ~~owner~~ of the above-described well, being first duly sworn on oath, says: That I have knowledge of the facts, statements, and matters herein contained and the log of the above-described well as filed and that the same are true and correct. So help me God.

(Signature) J. L. Martin Jr.  
827 Latimer Borger, Texas  
(Address)

SUBSCRIBED AND SWORN TO before me this 14 day of August, 19 70

My commission expires June 1, 1971

Sharon Shelton  
Notary Public.