

STATE OF KANSAS
STATE CORPORATION COMMISSION

15-057-20106-0000

WELL PLUGGING RECORD

Give All Information Completely
Make Required Affidavit
Mail or Deliver Report to
Conservation Division
State Corporation Comm.
245 North Water
Wichita, KS 67202

Ford County, Sec. 25 Twp. 28S Rge. 23 ~~EX~~W
Location as "NE/CNW $\frac{1}{4}$ SW $\frac{1}{4}$ " or footage from lines
C W/2


Lease Owner St. Joe Petroleum (U.S.) Corporation
Lease Name Copeland Well No. 1
Office Address P. O. Drawer 296, Midland, Texas 79701
Character of Well (Completed as Oil, Gas or Dry Hole)
Dry Hole

Date Well completed December 29, 1977
Application for plugging filed 19
Application for plugging approved January 2, 1978
Plugging commenced January 2, 1978
Plugging completed 19

Reason for abandonment of well or producing formation
No oil or gas indicated in tests.
If a producing well is abandoned, date of last production 19

Was permission obtained from the Conservation Division or
its agents before plugging was commenced? Yes

Name of Conservation Agent who supervised plugging of this well Clarence Thomas
Producing formation None Depth to top Bottom Total Depth of Well 5275'
Show depth and thickness of all water, oil and gas formations.

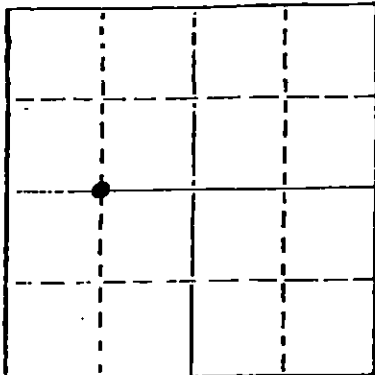

Locate well correctly on above
Section Plat

OIL, GAS OR WATER RECORDS

CASING RECORD

FORMATION	CONTENT	FROM	TO	SIZE	PUT IN	PULLED OUT

Describe in detail the manner in which the well was plugged, indicating where the mud fluid was placed and the method or methods used in introducing it into the hold. If cement or other plugs were used, state the character of same and depth placed, from feet to feet for each plug set.

Fifty sacks of Class "A" cement were used on first plug at 350'.
Ten sacks of Class "A" cement were used between 40' to ground level.
Five sacks of Class "A" cement were poured into the Rat Hole.
Five sacks of Class "A" cement were poured into the Mouse HOLE.

RECEIVED
STATE CORPORATION COMMISSION

JUN 21 1978
6-21-1978

CONSERVATION DIVISION

(If additional description is necessary, use BACK of this sheet)

Name of Plugging Contractor Halliburton Services - Pratt, Kansas

STATE OF OKLAHOMA COUNTY OF OKLAHOMA, ss.
John B. Kennedy, Vice President (employee of owner) or former operator
of the above-described well, being first duly sworn on oath, says: That I have knowledge of
the facts, statements, and matters herein contained and the log of the above-described well
as filed and that the same are true and correct. So help me God.

(Signature) John B. Kennedy
PLAINS RESOURCES INC., 2502 First National
Center, Oklahoma City, Oklahoma (Address) City, Oklahoma
73102

SUBSCRIBED AND SWORN TO before me this 15th day of March, 1978

Joyce M. Lavers
Joyce M. Lavers Notary Public.
Oklahoma County, Oklahoma

My commission expires April 8, 1981

Operator Plains Resources Inc.		DESIGNATE TYPE OF COMP.: OIL, GAS, DRY HOLE, SWDW, ETC.:
Well No. 1	Lease Name COPELAND	Dry hole
S 25 T 28 R 23 W		


WELL LOG

Show all important zones of porosity and contents thereof; cored intervals, and all drill-stem tests, including depth interval tested, cushion used, time tool open, flowing and shut-in pressures, and recoveries.

SHOW GEOLOGICAL MARKERS, LOGS RUN, OR OTHER DESCRIPTIVE INFORMATION.

FORMATION DESCRIPTION, CONTENTS, ETC.	TOP	BOTTOM	NAME	DEPTH
Shale and sands	Surface	640'	Cretaceous	
Anhydrite	640	650		
Shale and sand	650	1478		
Anhydrite and shale	1478	1540	Stone Corral	
Gypsum, shale and anhydrites	1540	2730	Permian	
Dolomites and limey dolostones	2734	2840	Chase Group	
Limestone and shale	3100		Council Grove	
Limestone	3302		Neva	
Limestone and shale	3610		Tarkio	
Shale	4356		Heebner	
Limestone and shale	4466	4920	Lansing/Kansas City	
Limestone	4930		Marmaton	
Sand and conglomerate (S.O. & G)	5190		Morrow	
Mississippian Lime (S.O. & G)	5204		Spergen	
Total Depth	5287'		Mississippian	

USE ADDITIONAL SHEETS, IF NECESSARY, TO COMPLETE WELL RECORD.

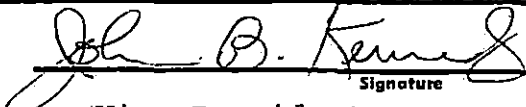Date Received	 Signature
	Vice President Title
	6-19-78 Date