


STATE OF KANSAS  
STATE CORPORATION COMMISSION

Give All Information Completely  
Make Required Affidavit  
Mail or Deliver Report to  
Conservation Division  
State Corporation Commission  
245 North Water  
Wichita, KS 67202

15-057-20085-0000

FORM CP-4

WELL PLUGGING RECORD

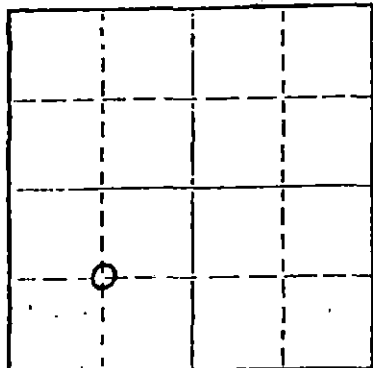

Locate well correctly on above Section Plot

FORD County. Sec. 33 Twp. 28 Rge. 24 (E) (W)  
Location as "NE/CNW/SE" or footage from lines Center SW 1/4  
Lease Owner BMG, INC.  
Lease Name ALLEN Well No. 1  
Office Address 1400 Metrobank Bldg, Denver, Co. 80202  
Character of Well (completed as Oil, Gas or Dry Hole) DRY HOLE  
Date well completed Feb. 15 1976  
Application for plugging filed 19  
Application for plugging approved 19  
Plugging commenced Feb. 16 1976  
Plugging completed Feb. 16 1976  
Reason for abandonment of well or producing formation DRY HOLE

If a producing well is abandoned, date of last production 19  
Was permission obtained from the Conservation Division or its agents before plugging was commenced? YES

Name of Conservation Agent who supervised plugging of this well Clarence Thomas  
Producing formation Depth to top Bottom Total Depth of Well Feet  
Show depth and thickness of all water, oil and gas formations.

OIL, GAS OR WATER RECORDS

CASING RECORD

FORMATION	CONTENT	FROM	TO	SIZE	PUT IN	PULLED OUT
		0	421	8-5/8	420	NONE

Describe in detail the manner in which the well was plugged, indicating where the mud fluid was placed and the method or methods used in introducing it into the hole. If cement or other plugs were used, state the character of same and depth placed, from feet to feet for each plug set.

45 sx. 900'  
35 sx. 390'  
15 sx. 40-0  
5 sx. Mouse Hole  
5 sx. Rat Hole

RECEIVED  
STATE CORPORATION COMMISSION

MAR 01 1976  
3-1-1976

CONSERVATION DIVISION  
Wichita, Kansas

(If additional description is necessary, use BACK of this sheet)

Name of Plugging Contractor B&N Drilling  
Address P.O. Box 846, Independence, Kansas 67301

STATE OF COLORADO COUNTY OF DENVER ss.  
JAMES JAMESON (employee of owner) or (owner) of the above-described

well, being first duly sworn on oath, says: That I have knowledge of the facts, statements, and matters herein contained and the log of the above-described well as filed and that the same are true and correct. So help me God.

(Signature) James Jameson  
1400 Metrobank Bldg. - Denver, Co. 80202  
(Address)

Subscribed and sworn to before me this 26 day of FEBRUARY 1976.

My commission expires December 18, 1978

Geraldine Lancia  
Notary Public.

**KANSAS DRILLERS LOG**


S. 33 T. 28 R. 24 <sup>X</sup> W

API No. 15 — Ford 057 — 20085-0000  
County Number

Loc. Center SW $\frac{1}{4}$

County Ford

640 Acres  
N

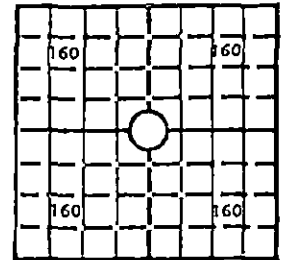

Locate well correctly

Elev.: Gr. \_\_\_\_\_

DF \_\_\_\_\_ KB \_\_\_\_\_

Operator  
**BMG, INC.**

Address  
**1400 Metro Bank Bldg., 17th St., Denver, Colorado 80202**

Well No. # 1 Lease Name Allen

Footage Location  
feet from (N) (S) line \_\_\_\_\_ feet from (E) (W) line \_\_\_\_\_

Principal Contractor B & N Drilling Company Geologist \_\_\_\_\_

Spud Date 2/8/76 Total Depth 3307' P.B.T.D. \_\_\_\_\_

Date Completed 1/17/76 Oil Purchaser \_\_\_\_\_

**CASING RECORD**

Report of all strings set — surface, intermediate, production, etc.

Purpose of string	Size hole drilled	Size casing set (in O.D.)	Weight lbs/ft.	Setting depth	Type cement	Sacks	Type and percent additives
Surface	12 $\frac{1}{2}$ "	8 5/8"		426'			

**LINER RECORD**

**PERFORATION RECORD**

Top, ft.	Bottom, ft.	Sacks cement	Shots per ft.	Size & type	Depth interval

**TUBING RECORD**

Size	Setting depth	Packer set at

**ACID, FRACTURE, SHOT, CEMENT SQUEEZE RECORD**

Amount and kind of material used

RECEIVED  
STATE GEOLOGICAL COMMISSION  
MAY 13 1976  
GENERAL INVESTIGATIVE DIVISION  
Wichita, Kansas

**INITIAL PRODUCTION**

Date of first production \_\_\_\_\_ Producing method (flowing, pumping, gas lift, etc.) \_\_\_\_\_

RATE OF PRODUCTION PER 24 HOURS	Oil	Gas	Water	Gas-oil ratio
	bbfs.	bbfs.	MCF	bbfs.

Disposition of gas (vented, used on lease or sold) \_\_\_\_\_ Producing interval (s) \_\_\_\_\_

INSTRUCTIONS: As provided in KCC Rule 82-2-125, within 90 days after completion of a well, one completed copy of this Drillers Log shall be transmitted to the State Geological Survey of Kansas, 4150 Monroe Street, Wichita, Kansas 67209. Copies of this form are available from the Conservation Division, State Corporation Commission, 3830 So. Meridian (P.O. Box 17027), Wichita, Kansas 66217. Phone AC 316-522-2206. If confidential custody is desired, please note Rule 82-2-125. Drillers Logs will be on an open file in the Oil and Gas Division, State Geological Survey of Kansas, Lawrence, Kansas 66044.

DESIGNATE TYPE OF COMP.: OIL, GAS, DRY HOLE, SWDW, ETC.:

Operator

BMG, INC.

Well No.

# 1

Lease Name

ALLEN

S 33 T 28 R 24 E W

**WELL LOG**

Show all important zones of porosity and contents thereof; cored intervals, and all drill-stem tests, including depth interval tested, cushion used, time tool open, flowing and shut-in pressures, and recoveries.

SHOW GEOLOGICAL MARKERS, LOGS RUN, OR OTHER DESCRIPTIVE INFORMATION.

FORMATION DESCRIPTION, CONTENTS, ETC.	TOP	BOTTOM	NAME	DEPTH
clay/sand	0	426		
shale/sand	426	1388		
shale/anhydrite	1388	1825		
shale/lime	1825	2405		
shale	2405	2591		
shale/lime	2591	2725		
shale/chert	2725	2785		
shale/lime	2785	3031		
lime	3031	3070		
lime/shale	3070	3307		

RECEIVED  
 STATE OF KANSAS  
 CONSERVATION DIVISION  
 WICHITA, KANSAS  
 MAY 13 1976

USE ADDITIONAL SHEETS, IF NECESSARY, TO COMPLETE WELL RECORD.

Date Received

Signature

Title

Date