

Give All Information Completely
Make Required Affidavit
Mail or Deliver Report to:
Conservation Division
State Corporation Commission
212 North Market, Insurance Bldg.
Wichita, Kansas

Re

WELL PLUGGING RECORD

Ford County, Sec. 22 Twp. 28S Rge. 25 (W)

Location as "NE/CNW/SW" or footage from lines 330' F S Land 1650' F W L

Lease Owner D. E. Dunne, Jr.

Lease Name Burnett Well No. 1

Office Address 1005 Central Building, Wichita, Kansas

Character of Well (completed as Oil, Gas or Dry Hole) Dry

Date well completed Washdown 10-7 19 60

Application for plugging filed 10-10 19 60

Application for plugging approved 10-14 19 60


Plugging commenced 10-7 19 60

Plugging completed 10-7 19 60

Reason for abandonment of well or producing formation Dry

If a producing well is abandoned, date of last production, 19

Was permission obtained from the Conservation Division or its agents before plugging was commenced? Yes

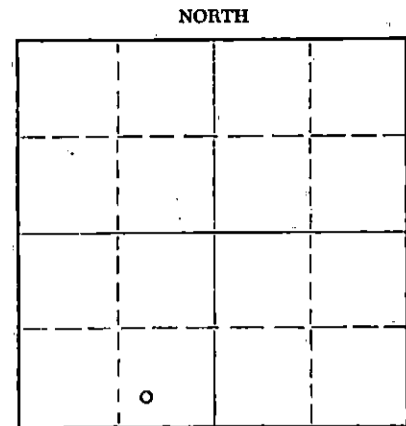

Locate well correctly on above Section Plat

Name of Conservation Agent who supervised plugging of this well Frank Broadfoot, St. John, Kansas

Producing formation _____ Depth to top _____ Bottom _____ Total Depth of Well 5031 Feet

Show depth and thickness of all water, oil and gas formations.

OIL, GAS OR WATER RECORDS

CASING RECORD

FORMATION	CONTENT	FROM	TO	SIZE	PUT IN	PULLED OUT
				8 5/8"	343.90'	-
				7"	1,194.63'	1,194.63'

Describe in detail the manner in which the well was plugged, indicating where the mud fluid was placed and the method or methods used in introducing it into the hole. If cement or other plugs were used, state the character of same and depth placed, from _____ feet to _____ feet for each plug set.

Plug hole at 300' through pipe

8 5/8 plug, 20 sacks cement 1/2 Hulls

Top plug at 35', 10 sacks cement and 1/2 Hulls

RECEIVED
STATE CORPORATION COMMISSION

OCT 19 1960
10-19-1960
CONSERVATION DIVISION

(If additional description is necessary, use BACK of this sheet)

Name of Plugging Contractor Twin Drilling, Inc.

Address 1005 Central Building, Wichita, Kansas

STATE OF Kansas, COUNTY OF Sedgwick, ss.
Almeda Day (employee of owner) or (owner or operator) of the above-described

well, being first duly sworn on oath, says: That I have knowledge of the facts, statements, and matters herein contained and the log of the above-described well as filed and that the same are true and correct. So help me, God.

(Signature) Almeda Day
1005 Central Building, Wichita, Kansas
(Address)

SUBSCRIBED AND SWORN TO before me this 18 day of October, 1960

My commission expires 9-29-64

James A. Hicks
Notary Public.

