

15-069-00020-0600

STATE OF KANSAS
STATE CORPORATION COMMISSION

WELL PLUGGING RECORD

OR


FORMATION PLUGGING RECORD

Strike out upper line
when reporting plug-
ging of formations.

Give All Information Completely
Make Required Affidavit
Mail or Deliver Report to:

Conservation Division
State Corporation Commission
800 Bittling Building
Wichita, Kansas

NORTH

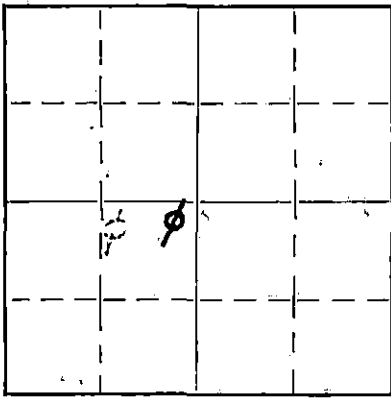

Locate well correctly on above
Section Plat

Gray County. Sec. 34 Twp. 28 Rge. 29 (W)
Location as "NE 1/4 NW 1/4 SW 1/4" or footage from lines 660' fr. N. line & 660' fr. E. line
Lease Owner Champlin Refining Company
Lease Name Becker Well No. 1
Office Address Enid, Oklahoma
Character of Well (Completed as Oil, Gas or Dry Hole) Dry hole
Date, well completed July 21, 1939 193
Application for plugging filed July 29, 1939 193
Application for plugging approved By telephone on July 24, 1939 193
Plugging Commenced July 25, 1939 193
Plugging Completed July 25, 1939 193
Reason for abandonment of well or producing formation Dry hole

If a producing well is abandoned, date of last production 193
Was permission obtained from the Conservation Division or its agents before plugging was com-
menced? Yes

Name of Conservation Agent who supervised plugging of this well Mr. Durkee, Lyons, Kans.
Producing formation Depth to top Bottom Total Depth of Well 650.5 Feet.

Show depth and thickness of all water, oil and gas formations.

OIL, GAS OR WATER RECORDS


CASING RECORD

Formation	Content	From	To	Size	Put In	Pulled Out
Dry hole					747'	none

Describe in detail the manner in which the well was plugged, indicating where the mud fluid was placed and the method or methods used in introducing it into the hole. If cement or other plugs were used, state the character of same and depth placed, from feet to feet for each plug set.

Filled with heavy mud from top to bottom between plugs;
cement 755 to 727 20 sax
cement 225 to 192 25 sax
20' cement base of cellar.
Weld cap over surface pipe.

PLUGGING
FILE SEC. 24 28 29
BOOK PAGE 72 LINE 43

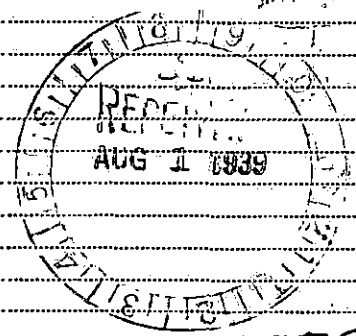

8-1-1939

(If additional description is necessary, use BACK of this sheet)

Correspondence regarding this well should be addressed to Champlin Refining Company
Address Enid, Oklahoma.

STATE OF Okla., COUNTY OF Garfield, ss.

(employee of owner) or (owner or operator) of the above-described well,
being first duly sworn on oath, says: That I have knowledge of the facts, statements, and matters herein contained and the log of the above-
described well as filed and that the same are true and correct, to the best of my knowledge and
belief.

(Signature) Floyd B. Wentworth
Bx 1078, Enid, Ok
(Address)

SUBSCRIBED AND SWORN to before me this 31 day of July, 1939

My commission expires Nov. 5 - 1939
Notary Public.