


Give All Information Completely
Make Required Affidavit
Mail or Deliver Report to:
Conservation Division
State Corporation Commission
211 No. Broadway
Wichita, Kansas

WELL PLUGGING RECORD

Gray County, Sec. 20 Twp. 28S Rge. 30 (E) W (W)

Location as "NE/CNW/SW" or footage from lines NE NE
Lease Owner Beardmore Drilling Company
Lease Name Yeager Well No. 1
Office Address 827 Beacon Bldg., Wichita 2, Kansas
Character of Well (completed as Oil, Gas or Dry Hole) Dry Hole
Date well completed 6-21 19 62
Application for plugging filed 6-21 19 62
Application for plugging approved 6-21 19 62
Plugging commenced 6-21 19 62
Plugging completed 6-21 19 62
Reason for abandonment of well or producing formation Dry Hole

NORTH

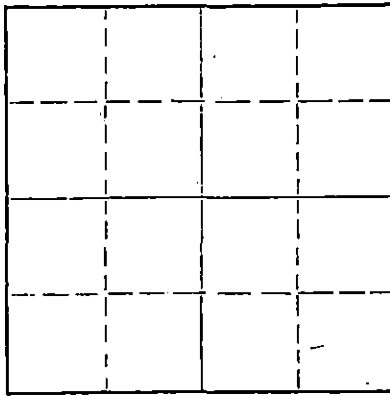

Locate well correctly on above
Section Plat

If a producing well is abandoned, date of last production _____ 19____
Was permission obtained from the Conservation Division or its agents before plugging was commenced? Yes

Name of Conservation Agent who supervised plugging of this well Hugh Scott
Producing formation _____ Depth to top _____ Bottom _____ Total Depth of Well 5610 Feet
Show depth and thickness of all water, oil and gas formations.

OIL, GAS OR WATER RECORDS

CASING RECORD

FORMATION	CONTENT	FROM	TO	SIZE	PUT IN	PULLED OUT
Sand and shale		0	700'			
Red Bed and shale		700'	1030'			
Shale, chalk & shells		1030'	1687'			
Lime and shale		1687'	1724'			
Anhydrite		1724'	1728'	8 5/8	1728'	-0-

Describe in detail the manner in which the well was plugged, indicating where the mud fluid was placed and the method or methods used in introducing it into the hole. If cement or other plugs were used, state the character of same and depth placed, from _____ feet to _____ feet for each plug set.

0 to 35' - 10 sacks cement
35' - wood plug
35' to 660' - heavy mud
660' to 750' - 30 sacks cement
750' - wood plug
750' to 5610' - heavy mud

RECEIVED
STATE CORPORATION COMMISSION

JUN 28 1962

CONSERVATION DIVISION
Wichita, Kansas

(If additional description is necessary, use BACK of this sheet)

Name of Plugging Contractor K & E Drilling Company, Inc.
Address Union Center Bldg., Wichita 2, Kansas

6-28-1962

STATE OF KANSAS, COUNTY OF SEDGWICK, ss.

Heber Beardmore (employee of owner) or (owner or operator) of the above-described well, being first duly sworn on oath, says: That I have knowledge of the facts, statements, and matters herein contained and the log of the above-described well as filed and that the same are true and correct. So help me God.

(Signature) Heber Beardmore
827 Beacon Bldg., Wichita 2, Kansas
(Address)

SUBSCRIBED AND SWORN TO before me this 27th day of June, 19 62

My commission expires 7-13-63
Shirley Ann Jackson
Notary Public.

15-069-00009-0000

DRILLER'S WELL LOG

OPERATOR: BEARDMORE DRILLING COMPANY

WELL NAME: YEAGER #1

LOCATION: C NE NE Sec. 20-28S-30W
Gray County, Kansas

CONTRACTOR: **K & E DRILLING, INC.**
719 UNION CENTER BLDG.
WICHITA, KANSAS

COMMENCED: 5-29-62

CASING RECORD: 8 5/8" @ 1728' w/875 sx.

COMPLETED: 6-20-62

ELEVATION: 2811 KB

2808 DF

ROTARY TOTAL DEPTH: 5610'

PRODUCTION: None. D & A

FORMATION RECORD

Depths shown indicate bottom of formations encountered.

Sand & Clay	400	Lime	4666
Sand & Shale	700	Shale & Lime	4770
Red Bed & Shale	1030	Lime	4803
Chalk & Anhydrite	1110	Lime & Shale	4980
Shale & Anhydrite	1185	Lime	5011
Shale & Sand	1405	Lime & Hard Sand	5046
Shale & Sand Streaks	1530	Shale & Lime w/ Streaks of Sand	5090
Red Bed & Shells	1687	Lime & Shale	5135
Lime & Shale	1724	Lime & Shale Streaks	5158
Anhydrite	1734	Shale & Streaks of Lime	5220
Shale & Shells	2095	Lime	5288
Shale	2180	Shale & Lime	5362
Shale w/Lime Streaks	2360	Lime, Chert & Shale	5385
Shale & Lime	2705	Lime	5447
Lime, Shale & Streaks of Chert	2790	Lime & Shale	5480
Lime & Shale	3050	Lime	5528
Lime	3400	Lime & Shale w/Streaks of Chert	5559
Lime & Chalk	3555	Lime & Chert	5610
Lime & Shale	3909		
Lime, Shale & Chalk	4045		
Lime & Shale	4140		
Lime	4330		
Lime & Streaks of Chalky Lime	4410		

RECEIVED
STATE CORPORATION COMMISSION

JUN 28 1962

CONSERVATION DIVISION
Wichita, Kansas

CERTIFICATION

State of KANSAS
County of SEDGWICK } ss:

I, H. L. Wilson, of K&E DRILLING, INC., upon oath state that the above and foregoing is a true and correct copy of the Driller's Log of the above named well.

H. L. Wilson
H. L. Wilson

Subscribed and sworn to before me this 26th day of June, 1962.

Patsy A. Roberts
Patsy A. Roberts Notary Public.

My Commission expires: April 17, 1966

