


STATE OF KANSAS
STATE CORPORATION COMMISSION
200 Colorado Derby Bldg.
Wichita, Kansas 67202

Form CP-4
Rev. 12-15-80

WELL PLUGGING RECORD

Give All Information Completely
Make Required Affidavit

COUNTY Pratt SEC. 29 TWP. 29S RGE. 13W NE/W
Location as in quarters or footage from lines:
C S/2 S/2 NW/4

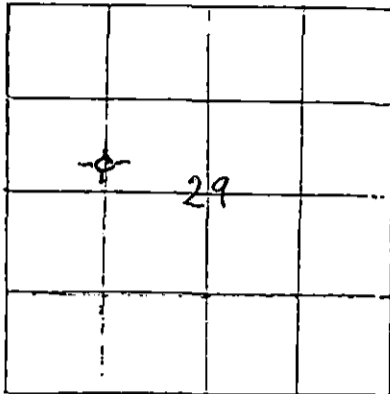

Locate Well
correctly on above
Section Platt.

Lease Owner Carl Todd
Lease Name Lambert Well No. 1-29
Office Address 1117 West River Blvd., Wichita, Ks. 67203
Character of Well (Completed as Oil, Gas or Dry Hole): D & A
Date Well Completed October 20, 1983
Application for plugging filed October 20, 1983
Plugging commenced October 20, 1983
Plugging completed October 20, 1983
Reason for abandonment of well or producing formation D & A

Was permission obtained from the Conservation Division or it's
Agent's before plugging was commenced? Yes

Name of Conservation Agent who supervised plugging of this well Glen Lacy
Producing formation D & A Depth to top _____ bottom T.D. 4,720'

Show depth and thickness of all water, oil and gas formations.

OIL, GAS OR WATER RECORDS

Casing Record

Formation	Content	From	To	Size	Put in	Pulled Out
				8 5/8"	251.18'	-0-

Describe in detail the manner in which the well was plugged, indicating where the mud
fluid was placed and the method or methods used in introducing it into the hold. If cement
or other plugs were used, state the character of same and depth placed, from _____ feet
to _____ feet for each plug set.

Plugged hole w/50 sx cement @ 780'
40 sx cement @ 300'
Hulls, plug & 10 sx cement @ 40'
10 sx cement in rathole
60/40 Pozmix, 2% Gel, 3% C.C.

(If additional description is necessary, use BACK of this sheet)


Name of Plugging Contractor Halliburton Services

STATE OF Kansas COUNTY OF Sedgewick, ss.

(employee of owner) or (owner or operator) of the
above-described well, being first duly sworn on oath, says: That I have knowledge of the
facts, statements, and matters herein contained and the log of the above-described well as
filed and that the same are true and correct. So help me God.

(Signature) Carl Todd
1117 West River Blvd Wichita KS
(Address) 67203

1st day of November 19 83

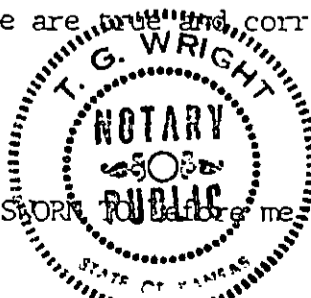

T.G. Wright
Notary Public.

Commission expires: 11-12-86

RECEIVED
STATE CORPORATION COMMISSION

NOV 7 1983

CONSERVATION DIVISION
Wichita, Kansas