


15.151-00224-00-00

STATE OF KANSAS
STATE CORPORATION COMMISSION

WELL PLUGGING RECORD

Give All Information Completely
Make Required Affidavit
Mail or Deliver Report to:
Conservation Division
State Corporation Commission
211 No. Broadway
Wichita, Kansas

NORTH

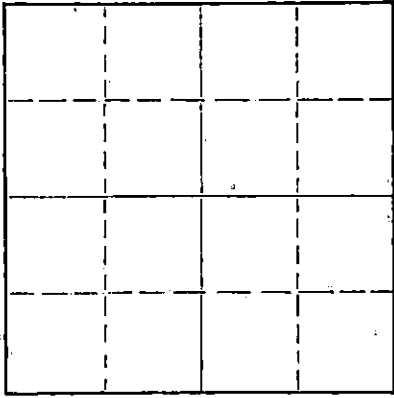

Locate well correctly on above
Section Flat

Pratt County, Sec. 28 Twp. 29 Rge. 13 (E) W (W)

Location as "NE/CNWxSWx" or footage from lines: NWNW SE
Lease Owner: Rine Drilling, Inc.
Lease Name: Jem #1 Well No. _____
Office Address: Wichita, Kansas
Character of Well (completed as Oil, Gas or Dry Hole) _____
Date well completed _____ 19____
Application for plugging filed _____ 19____
Application for plugging approved _____ 19____
Plugging commenced 8-14-58 _____ 19____
Plugging completed 8-19-58 _____ 19____
Reason for abandonment of well or producing formation _____

If a producing well is abandoned, date of last production _____ 19____
Was permission obtained from the Conservation Division or its agents before plugging was commenced? yes

Name of Conservation Agent who supervised plugging of this well Bill Lackamp
Producing formation _____ Depth to top _____ Bottom _____ Total Depth of Well 4718 Feet
Show depth and thickness of all water, oil and gas formations.

OIL, GAS OR WATER RECORDS

CASING RECORD

FORMATION	CONTENT	FROM	TO	SIZE	PUT IN	PULLED OUT
				8-5/8"	350'	none
				5-1/2"	4690'	3431'

Describe in detail the manner in which the well was plugged, indicating where the mud fluid was placed and the method or methods used in introducing it into the hole. If cement or other plugs were used, state the character of same and depth placed, from _____ feet to _____ feet for each plug set.

Checked the hole to 4654' and found it open.
Filled w/sand to 4575' and dumped 5 sacks of cement. K Pulled 60 jts of 5 1/8" casing, and circulated oil and water out of hole with 40 sacks of gel mud. Pulled rest of casing (44 jts) cleaned hole and bailed mud to 200'. Set a rock bridge to 190' and ran 20 sacks of cement. Mudded the hole to 35', set rock bridge and ran 10 sacks of cement to base of cellar.

(If additional description is necessary, use BACK of this sheet)

Name of Plugging Contractor West Supply Co., Inc.
Address Chase, Kansas

STATE OF KANSAS, COUNTY OF RICE, ss.
I, Noel Knight (employee of owner) or owner of the well of the above-described well, being first duly sworn on oath, says: That I have knowledge of the facts, statements, and matters herein contained and the log of the above-described well as filed and that the same are true and correct. So help me God.

(Signature) Noel Knight
Chase, Kansas
(Address)

SUBSCRIBED AND SWORN to before me this 27th day of August, 19 58

9-27-58

Thomas V. Siggins
Notary Public.

My commission expires _____

PLUGGING
FILE SEC. 28 T. 29 R. 13W
BOOK PAGE 121 LINE 6

RECEIVED
AUG 29 1958
CONSERVATION DIVISION
Wichita, Kansas