


15-156-10035-00-80

WELL PLUGGING RECORD

Give All Information Completely
Make Required Affidavit
Mail or Deliver Report to:
Conservation Division
State Corporation Commission
800 Bitting Building
Wichita, Kansas

Pratt County, Sec. 28 Twp. 29S Rge. 13 XXX (W)

Location as "NE/CNW/SW" or footage from lines C NW SE NE
Lease Owner The R. W. Rine Drilling Company, Excel Packing Company, Inc., and Roberts and Murphy
Lease Name Novotny Well No. 1
Office Address 420 Union Center, Wichita 2, Kansas
Character of Well (completed as Oil, Gas or Dry Hole) Dry Hole
Date well completed June 6 19 58
Application for plugging filed June 5 - phone 19 58
Application for plugging approved June 5 - phone 19 58
Plugging commenced June 6 19 58
Plugging completed June 6 19 58
Reason for abandonment of well or producing formation Dry hole

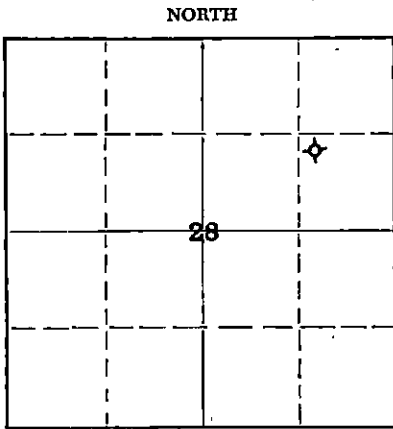

Locate well correctly on above Section Plat

If a producing well is abandoned, date of last production _____ 19 _____
Was permission obtained from the Conservation Division or its agents before plugging was commenced? Yes

Name of Conservation Agent who supervised plugging of this well Bill Lackamp, Stafford, Kansas
Producing formation _____ Depth to top _____ Bottom _____ Total Depth of Well 4775' ^{KB} Feet
Show depth and thickness of all water, oil and gas formations.

OIL, GAS OR WATER RECORDS

CASING RECORD

FORMATION	CONTENT	FROM	TO	SIZE	PUT IN	PULLED OUT
Sand		0'	180'			
Red Bed		180'	335'			
Shale and Shells		335'	401'	8 5/8"	401'	None

Describe in detail the manner in which the well was plugged, indicating where the mud fluid was placed and the method or methods used in introducing it into the hole. If cement or other plugs were used, state the character of same and depth placed, from _____ feet to _____ feet for each plug set.

Filled hole with heavy rotary mud from 4775' to 306'.
Set plug A 306' with 20 sacks cement through open-end drillpipe and 1/2 sack of cottonseed hulls, filled hole with heavy rotary mud from 306' to 40'. Set top plug at 40' with 10 sacks cement through open-end drillpipe and 1/2 sack of cottonseed hulls.
Plugging completed.

(If additional description is necessary, use BACK of this sheet)

Name of Plugging Contractor Beardmore Drilling Company
Address 827 Beacon Building, Wichita, Kansas

STATE OF KANSAS, COUNTY OF SEDGWICK, ss.
R. M. GREEN (employee of owner) or (owner/contractor) of the above-described well, being first duly sworn on oath, says: That I have knowledge of the facts, statements, and matters herein contained and the log of the above-described well as filed and that the same are true and correct. So help me God.

(Signature) R. M. Green
420 Union Center, Wichita 2, Kansas
(Address)

SUBSCRIBED AND SWORN to before me this 31st day of July, 1958

My commission expires July 9, 1960

Edna Landry
Notary Public,
STATE CORPORATION COMMISSION

PLUGGING
FILE SEC. 28 T. 29 R. 13W
BOOK PAGE 116 LINE 44

AUG 1 1958
08-01-58
DIVISION

RINE DRILLING COMPANY
 #1 Novotny
 NW SE NE Section 28-29S-13W
 Pratt County, Kansas

Drilled By: Beardmore Drilling Company
 Drilling Commenced: 5-22-58
 Drilling Completed: 6-6-58

Casing Record:

8-5/8" set at 401' with 300 sacks cement on 5-22-58.

Elevations: KB 1928
 DF 1925

<u>FORMATIONS</u>	<u>DEPTH</u>
Cellar	5
Sand	130
Red Bed	335
Shale and Shells	401
Red Bed	900
Shale	1600
Shale and Lime	1905
Lime	1990
Shale and Lime	3785
Sand	3855
Shale and Lime	3960
Lime	3985
Lime	4393
Shale and Lime	4475
Lime	4558
Lime and Chert	4609
Lime	4636
Sand and Shale	4730
Lime	4775
Rotary Total Depth	4775

TOPS

Heebner	3758 (-1828)
Brown Lansing	3939 (-2011)
L. Kansas City	3956 (-2028)
B. Kansas City	4331 (-2403)
Mississippi	4417 (-2489)
Kinderhook	4451 (-2523)
Viola	4496 (-2568)
Simpson Shale	4620 (-2692)
Simpson Sand	4629 (-2701)
Arbuckle	4720 (-2792)

RECEIVED
 STATE CORPORATION
 AUG 1 1958
 CONSERVATION DIVISION
 Wichita, Kansas

DST #1 4502-4516 Shut in 30 min., open 1 hr., shut in 30 min., gas to surface in 17 min., gauged 200,000 cf. for 20 min., in 30 min. fell back to 88,000 cf., stayed there throughout test. Recovered 60' mud. IF 75, FF 55, IBHP 1600, FBHP 1545, Hydrostatic 2640.

STATE OF KANSAS)
) ss
 COUNTY OF SEDGWICK)

PLUGGING
 FILE SEC 28 T. 29 R. 13W
 BOOK PAGE 110 LINE 44

I, the undersigned, being duly sworn on oath state that the above and within statement is a true and correct record and log of the well drilled on the location above described, to the best of my knowledge and belief.

Subscribed and sworn to before me this 17th day of June, 1958.

My Commission Expires:
 January 28, 1960

Leonard P. Tolle
 Leonard P. Tolle - Notary Public