


STATE OF KANSAS
STATE CORPORATION COMMISSION
200 Colorado Derby Bldg.
Wichita, Kansas 67202

Form CP-4
Rev. 12-15-80

WELL PLUGGING RECORD

Give All Information Completely
Make Required Affidavit

COUNTY Pratt SEC. 28 TWP. 29S RGE. 13 ~~E/W~~
Location as in quarters or footage from lines:
80' W of C. SE NW SE

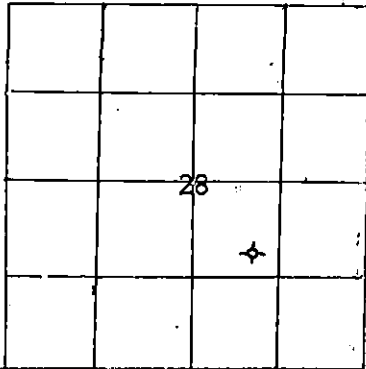

Locate Well
correctly on above
Section Pratt.

Lease Owner Texas Energies, Inc.
Lease Name Helmers Well No. 1-28
Office Address P.O. Box 947 Pratt, KS 67124
Character of Well (Completed as Oil, Gas or Dry Hole): Dry Hole
Date Well Completed 9-20-82
Application for plugging filed _____
Plugging commenced 9-20-82
Plugging completed 9-20-82
Reason for abandonment of well or producing formation _____

Dry Hole
Was permission obtained from the Conservation Division or it's
Agent's before plugging was commenced? Yes

Name of Conservation Agent who supervised plugging of this well Steve Durrant
Producing formation -- Depth to top -- bottom -- T.D. 4730
Show depth and thickness of all water, oil and gas formations.

OIL, GAS OR WATER RECORDS

Casing Record

Formation	Content	From	To	Size	Put in	Pulled Out
				10 3/4	100	None
				8 5/8	308	None

Describe in detail the manner in which the well was plugged, indicating where the mud fluid was placed and the method or methods used in introducing it into the hold. If cement or other plugs were used, state the character of same and depth placed, from _____ feet to _____ feet for each plug set.

Plugged well with 135 sxs 50-50 poz 4% Gel 3% CC as follows:

- cement plug at 720' with 70 sxs
- cement plug at 300' with 40 sxs
- rubber bridge plug with 1 sx hulls above and 1 sx hulls below and 10 sxs cement at 40'
- rathole with 10 sxs
- mousehole with 5 sxs

(If additional description is necessary, use BACK of this sheet)


Name of Plugging Contractor Wheatstate Drilling

STATE OF Kansas COUNTY OF Pratt, ss.
E. H. Bittner (employee of owner) or ~~owner or operator~~ of the above-described well, being first duly sworn on oath, says: That I have knowledge of the facts, statements, and matters herein contained and the log of the above-described well as filed and that the same are true and correct. So help me God.

(Signature) E H Bittner

P.O. Box 947 Pratt, KS 67124
(Address)

SUBSCRIBED AND SWORN TO before me this 27th day of September 1982

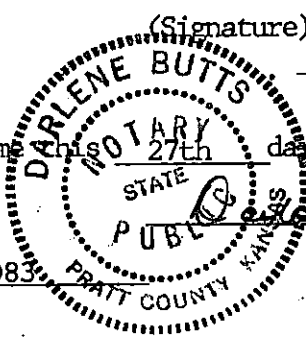

My Commission expires: April 23, 1983

RECEIVED
STATE CORPORATION COMMISSION
Notary Public.
007011982
CONSERVATION DIVISION
Wichita, Kansas