

STATE OF KANSAS  
STATE CORPORATION COMMISSION


WELL PLUGGING RECORD

Give All Information Completely  
Make Required Affidavit  
Mail or Deliver Report to:  
Conservation Division  
State Corporation Commission  
800 Bittling Building  
Wichita, Kansas

OR  
FORMATION PLUGGING RECORD

Strike out upper line  
when reporting plug-  
ging off formations.

NORTH

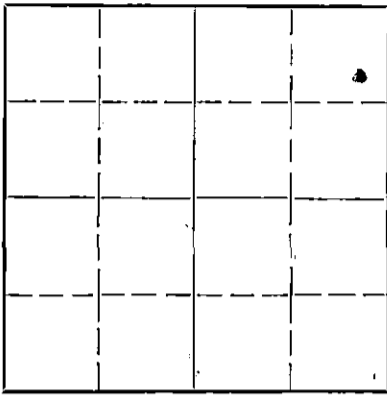

Locate well correctly on above  
Section Plat

Sedgwick County, Sec. 1 Twp. 26 Rge. 1 (E) 1 (W)  
Location as "NE $\frac{1}{4}$ NW $\frac{1}{4}$ SW $\frac{1}{4}$ " or footage from lines. SE $\frac{1}{4}$  NE $\frac{1}{4}$  NE $\frac{1}{4}$   
Lease Owner Solar Oil Corporation  
Lease Name J.A. Wilson Well No. 4  
Office Address 1117 Union National Bank Bldg., Wichita, Kansas  
Character of Well (completed as Oil, Gas or Dry Hole) Oil  
Date well completed April 27, 19 29  
Application for plugging filed April 4 19 44  
Application for plugging approved April 5 19 44  
Plugging commenced April 7 19 44  
Plugging completed May 3 19 44  
Reason for abandonment of well or producing formation Water encroachment  
If a producing well is abandoned, date of last production November 29 19 43  
Was permission obtained from the Conservation Division or its agents before plugging was commenced? Yes

Name of Conservation Agent who supervised plugging of this well Dwight Lilley  
Producing formation Hunton Depth to top 3379 Bottom 3387 Total Depth of Well 3406 Feet  
Show depth and thickness of all water, oil and gas formations. Plugged back 3395'


OIL, GAS OR WATER RECORDS

CASING RECORD

Formation	Content	From	To	Size	Put In	Pulled Out
lime	water	585	595			
lime	water	950	960	20"	63	none
lime	water	1110	1120			
shale	water	1305	1406	15 $\frac{1}{2}$ "	296	296
shale	water	1500	1510	12 $\frac{1}{2}$ "	1355	1355
lime	water	1945	1955	10"	2460	2460
lime	water	2315				
lime	water	2395		8 $\frac{1}{2}$ "	3023	2925
lime	oil	2515	2588			
lime	water & oil	2635	2640	6 5/8"	3356'	3020
lime	water	3043	3053	5 3/16"	65	none
sand	oil	3379	3387			
sand	water	3405	3406			

Describe in detail the manner in which the well was plugged, indicating where the mud fluid was placed and the method or methods used in introducing it into the hold. If cement or other plugs were used, state the character of same and depth placed, from.....feet to  
.....feet for each plug set.

Bridged hole on top of liner and put in 15 sacks cement with dump bailer. Ripped 7" OD at 3020' and pulled same. Ripped and shot 8 5/8" OD at 2925' and pulled same to top of Kansas City Lime. Filled with mud to top of Kansas City Lime, pulled balance of 8 5/8" OD and filled with mud to 1300'. Bridged hole 5' below bottom of 20" surface pipe and cemented with 15 sacks cement and filled with mud to 3' from top. Cemented with 5 sacks cement to surface.

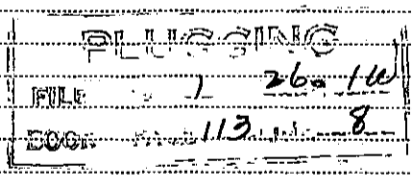

(If additional description is necessary, use BACK of this sheet)

Correspondence regarding this well should be addressed to Solar Oil Corporation  
Address 1117 Union National Bank Building, Wichita, Kansas

STATE OF KANSAS, COUNTY OF SEDGWICK, ss.  
R.E. Evans (employee of owner) or (owner or operator) of the above-described well,  
being first duly sworn on oath, says: That I have knowledge of the facts, statements, and matters herein contained and the log of the above-described well as filed and that the same are true and correct. So help me God.

(Signature) [Signature]

Wichita, Kansas  
(Address)

SUBSCRIBED AND SWORN to before me this 11th day of May

[Signature]  
Notary Public.

My commission expires October 31, 1945.

6-6-1944