

STATE OF KANSAS
STATE CORPORATION COMMISSION
Give All Information Completely
Make Required Affidavit
Mail or Deliver Report to:
Conservation Division
State Corporation Commission
800 Bittling Building
Wichita, Kansas

WELL PLUGGING RECORD

CORRECTED LOCATION REPORT OR

FORMATION PLUGGING RECORD

Strike out upper line when reporting plugging of formations.

Sedgwick County. Sec. 1 Twp 26 Rge 1W (E) (W)

Location as "NE $\frac{1}{4}$ NW $\frac{1}{4}$ SW $\frac{1}{4}$ " or footage from lines 810'N-990'E of SW Corner

Lease Owner Continental Oil Co. of SE/4 of Sec. 1

Lease Name L. K. Reed Well No. 7

Office Address Ponca City, Oklahoma

Character of Well (completed as Oil, Gas or Dry Hole) Oil

Date well completed March 7, 1930

Application for plugging filed November 17, 1947

Application for plugging approved November 18, 1947


Plugging commenced December 22, 1947

Plugging completed December 28, 1947

Reason for abandonment of well or producing formation Exhausted its capacity as a commercial producer

If a producing well is abandoned, date of last production May 16, 1945

Was permission obtained from the Conservation Division or its agents before plugging was commenced? Yes

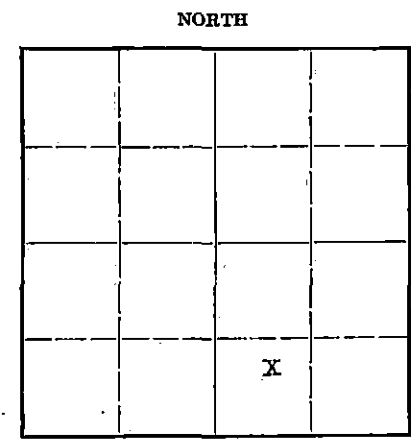

Locate well correctly on above Section Plat

Name of Conservation Agent who supervised plugging of this well D. C. Lilly

Producing formation Dolomite Depth to top 3370' Bottom 3372' Total Depth of Well 3372' Feet

Show depth and thickness of all water, oil and gas formations.

OIL, GAS OR WATER RECORDS

CASING RECORD

| Formation | Content | From | To | Size | Put In | Pulled Out |
|-----------|---------|------|----|--------|--------|------------|
| | | | | 20" | 54' | None |
| | | | | 16" | 120' | 120' |
| | | | | 8-5/8" | 3071' | 2319'11" |
| | | | | 7" | 3332' | 2383'20" |
| | | | | | | |
| | | | | | | |
| | | | | | | |
| | | | | | | |
| | | | | | | |


Describe in detail the manner in which the well was plugged, indicating where the mud fluid was placed and the method or methods used in introducing it into the hold. If cement or other plugs were used, state the character of same and depth placed, from _____ feet to _____ feet for each plug set.

- Dumped 5 sacks of cement from 3372' to 3355'
- Mudded hole from 3355' to 135'
- Rock bridge from 135' to 125'
- Dumped 15 sacks of cement from 125' to 115'
- Mudded hole from 115' to 5'
- Dumped 5 sacks of cement 5' to Surface

All cement was placed in hole with dump bailer

(If additional description is necessary, use BACK of this sheet.)

Correspondence regarding this well should be addressed to J. P. Neel
Address P. O. Box 248, Valley Center, Kansas

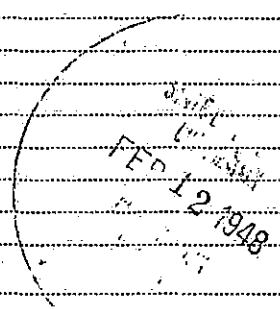

2-12-1948

STATE OF Kansas, COUNTY OF Sedgwick, ss.
J. P. Neel (employee of owner) or (owner or operator) of the above-described well,

being first duly sworn on oath, says: That I have knowledge of the facts, statements, and matters herein contained and the log of the above-described well as filed and that the same are true and correct. So help me God.

(Signature) J. P. Neel
Valley Center, Kansas (Address)

SUBSCRIBED AND SWORN to before me this 11 day of February, 1948

H. N. Waldern
Notary Public.

My commission expires 12-17-51

FORMATION RECORD

15-173-61718-0000

L. K. Reed No. 7

Date Spudded 1-19-30

810' N & 990' E

Date of Completion 3-7-30

of SW Corner of

SE $\frac{1}{4}$ Sec. 1-T26S-R1W

Sedgwick County, Kansas

| Name | From | To |
|---------------------|-------|------|
| Quick Sand | 0 | 50 |
| Lime Shell | 50 | 53 |
| Shale | 53 | 190 |
| Lime | 190 | 200 |
| Shale | 200 | 210 |
| Lime | 210 | 225 |
| Shale | 225 | 430 |
| Lime | 430 | 455 |
| Shale | 455 | 485 |
| Lime | 485 | 515 |
| Shale | 515 | 530 |
| Lime | 530 | 540 |
| Shale | 540 | 555 |
| Lime | 555 | 655 |
| Shale | 655 | 685 |
| Lime | 685 | 700 |
| Shale | 700 | 725 |
| Red Rock | 725 | 730 |
| Lime | 730 | 745 |
| Shale | 745 | 785 |
| Lime | 785 | 795 |
| Lime Shells & Shale | 795 | 850 |
| Shale | 850 | 905 |
| Lime | 905 | m915 |
| Shale | 915 0 | 965 |
| Lime | 965 | 1000 |
| Shale | 1000 | 1045 |
| Lime | 1045 | 1055 |
| Shale | 1055 | 1120 |
| Lime | 1120 | 1130 |
| Shale | 1130 | 1175 |
| Red. Rock | 1175 | 1185 |
| Shale | 1185 | 1320 |
| Lime | 1320 | 1328 |
| Shale | 1328 | 1350 |
| Lime | 1350 | 1355 |
| Shale | 1355 | 1380 |
| Lime | 1380 | 1395 |
| Shale | 1395 | 1420 |
| Lime | 1420 | 1490 |
| Shale | 1490 | 1560 |
| Lime | 1560 | 1610 |
| Shale | 1610 | 1655 |
| Lime | 1655 | 1670 |
| Shale | 1670 | 1680 |
| Lime | 1680 | 1725 |
| Shale | 1725 | 1750 |
| Lime | 1750 | 1810 |
| Shale | 1810 | 1820 |
| Lime | 1820 | 1980 |


Set 20" at 54'
Set 15 $\frac{1}{2}$ " at 119'9"

2 Bailers water

Set 12 $\frac{1}{2}$ " at 1312'

4 Bailers water

PLUGGING
FILE SEC 1 T26 R1W
BOOK PAGE 147 LINE 32

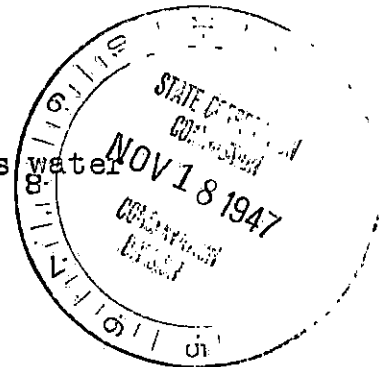

| | From | To | |
|-------------|------|-------|-----------------------|
| Shale | 1980 | 2000 | |
| Lime | 2000 | 2030 | |
| Shale | 2030 | 2100 | Set 10" at 2033' |
| Lime | 2100 | 2105 | |
| Shale | 2105 | 2350 | |
| Lime | 2350 | 2480 | 12 Bailers water |
| Shale | 2480 | 2550 | |
| Lime | 2550 | 2710 | HFW - 2580 - 2590 |
| Shale | 2710 | 2810 | |
| Lime | 2810 | 2840 | |
| Shale | 2840 | 3045 | |
| Lime | 3045 | 3265 | HFW 3070 - 3080 |
| Shale | 3265 | 3270 | Set 8 1/4" at 3071' |
| Lime | 3270 | 3280 | |
| Shale | 3280 | 3352 | Set 6-5/8" at 3331'9" |
| Sand | 3352 | 3353 | Show of Oil |
| Shale light | 3353 | 3370 | |
| Sand | 3370 | 3372 | Oil |
| Total Depth | | 3372' | |

Casing Record

| <u>SIZE</u> | <u>Weight</u> | <u>Amt. Run</u> | <u>Amt Pulled</u> | <u>Amt. Left in</u> | <u>Sacks Cement Used</u> |
|-------------|---------------|-----------------|-------------------|---------------------|--------------------------|
| 20" | 90# | 54' | None | 54' | None |
| 15 1/8" | 70# | 119'9" | None | 119'9" | None |
| 12 1/2" | 50# | 1312' | 1312' | None | None |
| 10" | 40# | 2033' | 2033' | None | None |
| 8 1/4" | 32# | 3071' | None | 3071' | None |
| 6-5/8" | 24# | 3331'9" | None | 3331'9" | 65 sacks |

