


STATE OF KANSAS
STATE CORPORATION COMMISSION

Give All Information Completely
Make Required Affidavit
Mail or Deliver Report to:
Conservation Division
State Corporation Commission
800 Bittig Building
Wichita, Kansas

WELL PLUGGING RECORD

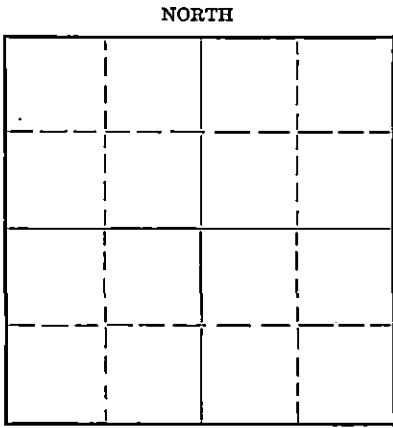

Locate well correctly on above
Section Plot

Sedgwick County. Sec. 2 Twp. 27 Rge. 1W (E) (W)
Location as "NE/CNW $\frac{1}{4}$ /SW $\frac{1}{4}$ " or footage from lines NW SW SE
Lease Owner Southwest Grease & Oil Co.
Lease Name Pritchard #1 Well No. 1
Office Address 220 West Waterman
Character of Well (completed as Oil, Gas or Dry Hole) dry hole
Date well completed January 20, 1951 19
Application for plugging filed same 19
Application for plugging approved same 19
Plugging commenced same 19
Plugging completed same 19
Reason for abandonment of well or producing formation dry hole
If a producing well is abandoned, date of last production _____ 19
Was permission obtained from the Conservation Division or its agents before plugging was commenced? yes

Name of Conservation Agent who supervised plugging of this well _____
Producing formation none Depth to top _____ Bottom _____ Total Depth of Well _____ Feet
Show depth and thickness of all water, oil and gas formations.

OIL, GAS OR WATER RECORDS

CASING RECORD

Formation	Content	From Tops	To	Size	Put In	Pulled Out
Kansas City		2594	-1266			
Mississippi		3082	-1764			
Viola		3415	-2087			
Simpson		3420	-2092	8 5/8"	209'	none

Describe in detail the manner in which the well was plugged, indicating where the mud fluid was placed and the method or methods used in introducing it into the hole. If cement or other plugs were used, state the character of same and depth placed, from _____ feet to _____ feet for each plug set.

Set first plug @ 209', put in 15 sacks cement; set second plug @ 25', filled w/ 5 sacks cement.

RECEIVED
STATE CORPORATION COMMISSION
FEB 14 1951
CONSERVATION DIVISION
Wichita, Kansas

2-14-1951

(If additional description is necessary, use BACK of this sheet)

Correspondence regarding this well should be addressed to Laura Jane Oil Co., Inc., (Contractor)
Address 817 Central Building,
Wichita, Kansas

STATE OF Kansas, COUNTY OF Sedgwick, SS.
H. D. Shawver (employee of owner) or (owner or operator) of the above-described well,
being first duly sworn on oath, says: That I have knowledge of the facts, statements, and matters herein contained and the log of the above-described well as filed and that the same are true and correct. So help me God.

(Signature) H. D. Shawver
H. D. Shawver

(Address)

SUBSCRIBED AND SWORN TO before me this 1st day of February, 1951

Coral F. Fair

Notary Public.

My commission expires 6/28/52

PLUGGING
FILE SEC-21278-14
BOOK PAGE 66, PAGE 36

DRILLING LOG

WELL NAME: Pritchard # 1 LOCATION: NW SW SE, 2-27-1W
 OWNERS: Southwest Grease & Oil Sedgwick Co., Kansas
 CONTRACTORS: Laura Jane Oil Co., Inc. ELEVATION: 1325 DF
 COMD: 1-9-51 1325 Gr
 COMP: 1-20-51 CASING RECORD: 8 3/8" @ 209'
 PRODUCTION: Dry

<u>FORMATION</u>	<u>TO</u>
Sand	95
Shale	209
Shale - Lime	405
Red Rock	445
Shale - Shells	715
Lime - Shale	860
Shale - Shells	975
Lime	1067
Shale - Lime	1440
Shale - Shells	1660
Lime - Shale	2594
Lime	2795
Shale - Lime	2855
Shale	2950
Shale - Lime	3082
Lime	3085
Chat	3170
Lime	3390
Shale	3415
Lime	3450
Sand	3455
Lime - Shale	3455

Tops

Kansas City	2594 - 1800
Mississippi	3082 - 1754
Viola	3415 - 2057
Simpson	3450 - 2092

T D Rotary

I certify that the above is a true and correct copy of the log of the Pritchard # 1, NW SW SE, 2-27-1W, Sedgwick County, Kansas, to the best of my knowledge.

LAURA JANE OIL CO., INC.

BY: H. D. Shawver
H. D. SHAWVER

Sworn and subscribed to before me this 2nd day of February, 1951

Carol F. Dyer
NOTARY PUBLIC

My Comm. Expires 6-28-52

RECEIVED
STATE CORPORATION COMMISSION
FEB 14 1951
CONSERVATION DIVISION
Wichita, Kansas

FLUGGING
FILE SEC. 2127044
BOOK PAGE 26 LINE 36