

STATE OF KANSAS  
STATE CORPORATION COMMISSION


WELL PLUGGING RECORD

Give All Information Completely  
Make Required Affidavit  
Mail or Deliver Report to:  
Conservation Division  
State Corporation Commission  
800 Bitting Building  
Wichita, Kansas

OR  
FORMATION PLUGGING RECORD

Strike out upper line  
when reporting plug-  
ging off formations.

NORTH

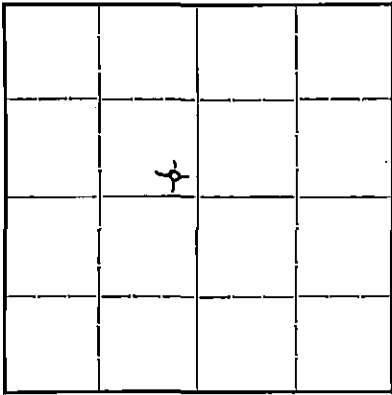

Locate well correctly on above  
Section Plat

Sedgwick County, Sec. 2 Twp. 27 Rge. 1 (E) (W)

Location as "NE 1/4 NW 1/4 SW 1/4" or footage from lines... SE SE NW

Lease Owner The Drillers Gas Company

Lease Name K. Johnson Well No. 1

Office Address Insurance Bldg., 212 N. Market St., Wichita 2, Kansas

Character of Well (completed as Oil, Gas or Dry Hole) Dry hole

Date, well completed June 3 19 50

Application for plugging filed July 12 19 50

Application for plugging approved July 17 19 50

Plugging Commenced October 23 19 50

Plugging Completed October 26 19 50

Reason for abandonment of well or producing formation Nonproductive

If a producing well is abandoned, date of last production None 19

Was permission obtained from the Conservation Division or its agents before plugging was com-  
menced? Yes

Name of Conservation Agent who supervised plugging of this well D. C. Lilley

Producing formation Dry Depth to top Bottom Total Depth of Well 3412 1/2 Feet

Show depth and thickness of all water, oil and gas formations. P.B. 2704 1/2

OIL, GAS OR WATER RECORDS

CASING RECORD

Formation	Content	From	To	Size	Put In	Pulled Out
Kansas City		258 1/2		8 5/8	210	0
Mississippi		3068		5 1/2	2697	2083
Viola		3400	340 1/2			
Simpson		340 1/2	3412 1/2			

Describe in detail the manner in which the well was plugged, indicating where the mud fluid was placed and the method or methods used in introducing it into the hole. If cement or other plugs were used, state the character of same and depth placed, from \_\_\_\_\_ feet to \_\_\_\_\_ feet for each plug set.

Filled hole with gravel 2704 1/2 to 2690

Dumped 4 sacks cement

Recovered 2083 ft. 5 1/2"

Mudded hole. Set plug @ 210' and 10 ft. rock bridge

Ran 12 sacks cement

Mud to 15 ft. rock bridge and 2 sacks cement

RECEIVED  
STATE CORPORATION COMMISSION  
NOV 8 - 1950  
CONSERVATION DIVISION  
Wichita, Kansas

(If additional description is necessary, use BACK of this sheet)

Correspondence regarding this well should be addressed to The Drillers Gas Company  
Address Insurance Building, 212 North Market Street, Wichita 2, Kansas

STATE OF KANSAS, COUNTY OF SEDGWICK, ss.  
Glen C. Thrasher (employee of owner) or (owner or operator) of the above-described well,  
being first duly sworn on oath, says: That I have knowledge of the facts, statements, and matters herein contained and the log of the above-described well as filed and that the same are true and correct. So help me God.

(Signature) Glen C. Thrasher

Insurance Bldg., 212 No. Market St., Wichita 2  
(Address)

SUBSCRIBED AND SWORN to before me this 7 day of November, 1950

Bertha L. Wilson

Notary Public.

My commission expires August 13, 1951

PLUGGING  
FILE SEC 2 T 27 R 10  
BOOK PAGE 16 LINE 34

WELL LOG BUREAU -- KANSAS GEOLOGICAL SOCIETY


508 E. Murdock, Wichita, Kansas

Company - THE DRILLERS GAS COMPANY  
Farm - Johnson No. 1

SEC. 2 T. 27 R. 1W  
SE SE NW

Total Depth. 3412½  
Comm. 1-20-50 Comp. 6-3-50  
Shot or Treated. 1000 acid  
Contractor. Springer and Harper  
Issued. 7-15-50

County. Sedgwick  
KANSAS

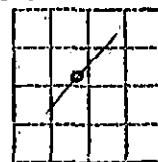

Elevation. 1327

Production. dry

CASING:

8 5/8" 210' cem w/175 sx.  
5½" OD 3408' cem w/250 sx.

Figures Indicate Bottom of Formations.

surface sand, clay	60
shale, shells	210
anhydrite	332
anhydrite, shale	355
anhydrite	385
lime, shale	475
lime	590
sand	620
lime	635
shale	690
lime, shale	710
redrock	725
lime	750
lime, shale	910
lime	960
sand	990
lime, shale	1185
shale	1260
sand	1300
lime, shale	1835
shale	1855
lime	1965
lime, shale	2290
lime	2320
lime, shale	2615
lime	2825
shale	3069
lime Miss.	3082
lime	3299
lime, shale	3395
shale	3400
Viola	3405
lime	3409
lime HFW	3412½
Total depth	

Tops:  
Kansas City 2584  
Mississippi 3068  
Viola 3400  
Simpson dolomite 3404

Lane Well plug 3170'  
35 ¢, 3070-82, show oil.  
1000 acid, swab water.  
L-W plug 2742, 36¢ 2698-2700, SSO and 3½ BW  
in 1½ hrs. 500 acid, swb 18 BWPH.  
squeeze 250 sacks, 2698-2710  
Clean out cement to 2741.  
35 ¢ 2698-2704, 1 bbl water pr hr.  
Squeeze perms w/50 sacks.  
Shot off pipe at 2213' and pulled pipe.  
Set whipstock and redrilled to 2698'.  
5½" 2697' w/100 sx  
- New Kansas City Top 2586'  
Total depth 2704½  
350 gal acid.  
- Pumped 6 bbl oil / 55 bbl wtr, 24 hrs.  
dry and abandoned.

PLUGGING  
FILE SEC 2 T 27 R 1W  
BOOK PAGE 16 LINE 34

RECEIVED

Conservation Div.

JUL 15 1950

STATE CORPORATION  
COMMISSION  
KANSAS