


STATE OF KANSAS  
STATE CORPORATION COMMISSION

Give All Information Completely  
Make Required Affidavit  
Mail or Deliver Report to:  
Conservation Division  
State Corporation Commission  
800 Blitting Building  
Wichita, Kansas

WELL PLUGGING RECORD

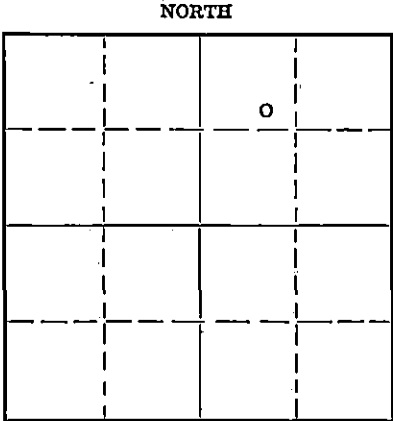

Locate well correctly on above Section Plat

Sedgwick County. Sec. 2 Twp. 27 Rge. 1 (E) 1 (W)  
Location as "NE/CNW $\frac{1}{4}$ SW $\frac{1}{4}$ " or footage from lines SE NW NE  
Lease Owner Drillers Production Company  
Lease Name P. Widner Well No. 1  
Office Address Insurance Bldg., 212 No. Market St., Wichita 2, Kansas  
Character of Well (completed as Oil, Gas or Dry Hole) Dry hole  
Date well completed June 2 1951  
Application for plugging filed May 14 1951  
Application for plugging approved May 19 1951  
Plugging commenced May 29 1951  
Plugging completed June 2 1951  
Reason for abandonment of well or producing formation Dry hole

If a producing well is abandoned, date of last production 19  
Was permission obtained from the Conservation Division or its agents before plugging was commenced? Yes

Name of Conservation Agent who supervised plugging of this well D. C. Lilley  
Producing formation Depth to top Bottom Total Depth of Well 2727 Feet  
Show depth and thickness of all water, oil and gas formations.

OIL, GAS OR WATER RECORDS

CASING RECORD

Formation	Content	From	To	Size	Put In	Pulled Out
				10 3/4"	210	None
				7"	2727	1950

Describe in detail the manner in which the well was plugged, indicating where the mud fluid was placed and the method or methods used in introducing it into the hole. If cement or other plugs were used, state the character of same and depth placed, from feet to feet for each plug set.

Filled back with coarse sand 2711' to 2695'.  
Dumped 3 1/2 sacks cement. Recovered 1950' of 7" casing. Mudded hole to 215'. Set 10' rock bridge. Dumped 15 sacks cement. Mud to 10' bridge and 5 sacks of cement.

(If additional description is necessary, use BACK of this sheet)

Correspondence regarding this well should be addressed to Drillers Production Company  
Address Insurance Building, 212 No. Market St., Wichita 2, Kansas

STATE OF KANSAS, COUNTY OF SEDGWICK, ss.  
Glen C. Thrasher (employee of owner) or (owner or operator) of the above-described well,  
being first duly sworn on oath, says: That I have knowledge of the facts, statements, and matters herein contained and the log of the above-described well as filed and that the same are true and correct. So help me God.

(Signature) *Glen C. Thrasher*  
Insurance Bldg., 212 No. Market St., Wichita, Ks.  
(Address)

SUBSCRIBED AND SWORN to before me this 14th day of June 1951

My commission expires August 13, 1951

**PLUGGING**  
FILE SEC-2127R1W  
BOOK PAGE 83 LINE 11

28-5091-s 8-50-10M

**RECEIVED** Notary Public.  
STATE CORPORATION COMMISSION  
JUN 21 1951 6-21-51  
CONSERVATION DIVISION  
Wichita, Kansas

WELL LOG BUREAU—KANSAS GEOLOGICAL SOCIETY  
508 East Murdock, Wichita, Kansas

Company - DRILLERS PRODUCTION CO.  
Farm - P. Widner No. 1

SEC. 2 T. 27 R. 1W  
SE NW NE

Total Depth. 2727  
Comm. 3-22-51 Comp. 5-10-51  
Shot or Treated.  
Contractor. Springer & Harper  
Issued. 6-23-51

County. Sedgwick  
KANSAS



Elevation. 1328 R.B.

Production. dry

CASING:

10" 210' cem w/250 sx  
7" 2727' cem w/125 sx

Figures Indicate Bottom of Formations.

sand	90
shale	110
shale, shells	165
anhydrite	250
lime, shale	365
lime	400
shale, lime	480
lime	575
lime sandy	600
shale, lime	1790
lime	1930
shale, lime	2320
lime	2387
shale, lime	2495
shale	2585
lime	2727
Total Depth	

Tops:

Brown Lime	2265
Lansing	2305
Kansas City	2585

DST: 2588-03, open 30 min.  
Rec. 30' mud.

CO to 2723

18 Shots 2704-08, show oil  
and water.

Acid 750 Squeeze

41 Shots 2696-2710

Acid 500 Squeeze

24 Shots 2699½-2704

Acid 2000

Pump 4 BFPH - 99% wtr.

RECEIVED  
STATE CORPORATION COMMISSION  
JUN 27 1951  
CONSERVATION DIVISION  
Wichita, Kansas

**PLUGGING**  
FILE SEC 2 T 27 R 1W  
BOOK PAGE 82 LINE 11