

SP

STATE OF KANSAS CORPORATION COMMISSION


Form CP-4

Give All in on Completely
Make Required Affidavit
Mail or Deliver Report to:
Conservation Division
State Corporation Commission
212 No. Market
Wichita, Kansas 67202

WELL PLUGGING RECORD

Sedgwick County. Sec. 2 Twp. 27 Rge. 1 ^W(E) (W)
NE NWSE

Location as "NE/CNW/SW" or footage from lines
Lease Owner Drillers Production Company
Lease Name Ott #4 Well No.
Office Address Wichita, Kansas 67202
Character of Well (completed as Oil, Gas or Dry Hole)
Date well completed 19
Application for plugging filed 19
Application for plugging approved 19
Plugging commenced 12/30/70 19
Plugging completed 1/6/71 19
Reason for abandonment of well or producing formation depleted.

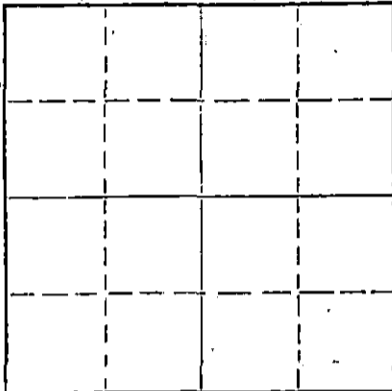

Locate well correctly on above Section Plat

If a producing well is abandoned, date of last production 19
Was permission obtained from the Conservation Division or its agents before plugging was commenced? yes

Name of Conservation Agent who supervised plugging of this well Dewey
Producing formation Depth to top Bottom Total Depth of Well 2711 Feet
Show depth and thickness of all water, oil and gas formations.

OIL, GAS OR WATER RECORDS

CASING RECORD

FORMATION	CONTENT	FROM	TO	SIZE	PUT IN	PULLED OUT
				8-5/8	224	none
				5 1/2"	2707'	2063'

Describe in detail the manner in which the well was plugged, indicating where the mud fluid was placed and the method or methods used in introducing it into the hole. If cement or other plugs were used, state the character of same and depth placed, from feet to feet for each plug set.

Checked bottom, ran sand to 2685', dumped 5 sacks of cement.
Shot pipe at 2080', worked pipe loose and pulled 66 joints.
Bailed hole to 235' to 226' rock, 220 to 0 3 1/2 yards ready mix.
Tallied pipe.

PLUGGING COMPLETE.

RECEIVED
STATE CORPORATION COMMISSION
JAN 28 1971
CONSERVATION DIVISION
Wichita, Kansas

(If additional description is necessary, use BACK of this sheet)

Name of Plugging Contractor KNIGHT CASING PULLING CO., INC
Address Chase, Kansas

STATE OF Kansas COUNTY OF Rice
Noel J. Knight, ss.

(employee of owner) or (owner or operator) of the above-described well, being first duly sworn on oath, says: That I have knowledge of the facts, statements, and matters herein contained and the log of the above-described well as filed and that the same are true and correct. So help me God.

(Signature)

Noel Knight
Chase, Kansas
(Address)

SUBSCRIBED AND SWORN to before me this 11th day of January, 19 71

My commission expires 2/15/71

Notary Public.

KANSAS WILSON LOG BUREAU -- KANSAS GEOLOGICAL SOCIETY
505 EAST MURDOCK - WICHITA, KANSAS

SP

COMPANY DRILLERS GAS CO.

SEC. 2 T. 27 N. 1W
LOC. NE NW SE

FARM K. W. Ott

NO. 4

TOTAL DEPTH 2711

COMM. 11-12-50


COMP. 12-21-50

COUNTY Sedgwick
KANSAS

SHOT OR TREATED

CONTRACTOR Springer & Harper

ISSUED 1-13-51

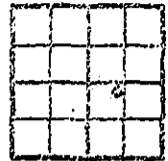

CAGING

8 5/8" 224' cem. w/225 sx.
5 1/2" 2707' cem. w/200 sx.

ELEVATION

PRODUCTION Est. 10 BOPD

sand	75
shale & shells	177
anhyd.	225
lime	415
lime & shale	750
lime	800
shale & lime	920
shale & shells	1640
lime	1715
lime & shale	1745
lime	1810
lime & shale	1950
lime	2110
shale & shells	2270
lime	2290
lime & shale	2520
shale	2595
lime RTD	2710
lime	2711
Total Depth	

FIGURES INDICATE BOTTOM OF FORMATIONS

Tops:	
Heebner	2055
Brown lime	2270
Kansas City	2594

RECEIVED
STATE CORPORATION COMMISSION
DEC 14 1970
CONSERVATION DIVISION
Wichita, Kansas