

9

STATE OF KANSAS
STATE CORPORATION COMMISSION

Form CP-4


Give All Information Completely
Make Required Affidavit
Mail or Deliver Report to:
Conservation Division
State Corporation Commission
212 No. Market
Wichita, Kansas 67202

WELL PLUGGING RECORD

Sedgwick County, Sec. 2 Twp. 27 Rge. 1 (E) (W)

Location as "NE/CNW/SW" or footage from lines SW SE NE
Lease Owner Drillers Production Company
Lease Name Ott #9 Well No.
Office Address Wichita, Kansas 67202
Character of Well (completed as Oil, Gas or Dry Hole)
Date well completed 19
Application for plugging filed 19
Application for plugging approved 19
Plugging commenced 1/16/71 19
Plugging completed 1/19/71 19
Reason for abandonment of well or producing formation depleted.

NORTH

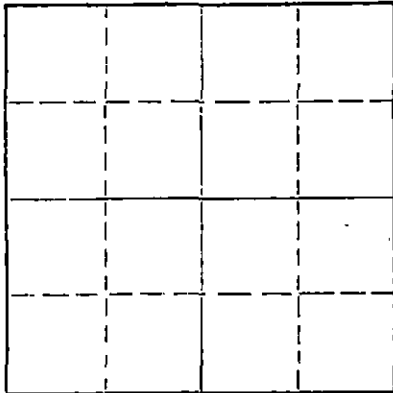

Locate well correctly on above
Section Plat

If a producing well is abandoned, date of last production 19
Was permission obtained from the Conservation Division or its agents before plugging was commenced? yes

Name of Conservation Agent who supervised plugging of this well Dewey
Producing formation Depth to top Bottom Total Depth of Well 2710' Feet
Show depth and thickness of all water, oil and gas formations.

OIL, GAS OR WATER RECORDS

CASING RECORD

FORMATION	CONTENT	FROM	TO	SIZE	PUT IN	PULLED OUT
				8-5/8	205	none
				4 1/2"	2708'	2084'

Describe in detail the manner in which the well was plugged, indicating where the mud fluid was placed and the method or methods used in introducing it into the hole. If cement or other plugs were used, state the character of same and depth placed, from feet to feet for each plug set.

Sanded hole to 2700', set 3 sacks of cement. Shot pipe at 2196', 2098', pulled 66 joints. Bailed hole to 240', 15' rock bridge to 225' and ran 3 1/2 yards ready mix.

PLUGGING COMPLETE.

RECEIVED
STATE CORPORATION COMMISSION
FEB 8 1971
CONSERVATION DIVISION
Wichita, Kansas

(If additional description is necessary, use BACK of this sheet)
KNIGHT CASING PULLING CO., INC.

Name of Plugging Contractor
Address CHASE, KANSAS

STATE OF KANSAS COUNTY OF RICE
NOEL J. KNIGHT, ss.

(employee of owner) or (owner or operator) of the above-described well, being first duly sworn on oath, says: That I have knowledge of the facts, statements, and matters herein contained and the log of the above-described well as filed and that the same are true and correct. So help me God.

(Signature) Noel Knight
CHASE, KANSAS
(Address)

SUBSCRIBED AND SWORN TO before me this 27th day of January, 1971

My commission expires 2/15/71

Margaret Melcher
Notary Public.

RECEIVED
STATE CORPORATION COMMISSION
DEC 14 1970
CONSERVATION DIVISION
Wichita, Kansas

DRILLERS LOG

OTT NO. 9


CASING RECORD: OPERATOR: Drillers Production Co. DESCRIPTION:
8-5/8" @ 205' CONTRACTOR: Sage Drilling Co., Inc. SW SE NE
w/225 sax cement COMMENCED: February 15, 1969 Sec. 2-27S-1W
Sedgwick Co., Kans.
TOTAL DEPTH: 2708' COMPLETED: February 19, 1969 ELEVATION: 1330KB

<u>FORMATION</u>	<u>FROM</u>	<u>TO</u>	<u>REMARKS</u>
Surface Soil & Sand	0	60	
Blue Shale	60	629	
Lime & Shale	629	1020	
Shale & Lime	1020	2708	4 1/2" @ 2708' w/100 sax

I certify that this is a true and correct copy of the above log to the best of my knowledge.

SAGE DRILLING CO., INC.

BY Wayne W. Kahmeyer
Wayne W. Kahmeyer

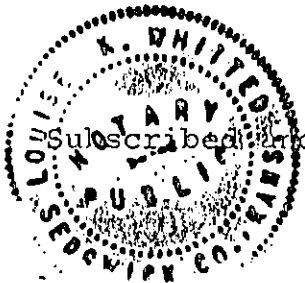

Subscribed and sworn to before me this 21st day of February, 1969.

Louise K. Whitted
Louise K. Whitted, Notary Public

My commission expires:
November 26, 1970.