


15-173-01834-0000

STATE OF KANSAS
STATE CORPORATION COMMISSION
CONSERVATION DIVISION
P. O. BOX 17027
WICHITA, KANSAS 67217

FORM CP-4

WELL PLUGGING RECORD

NORTH

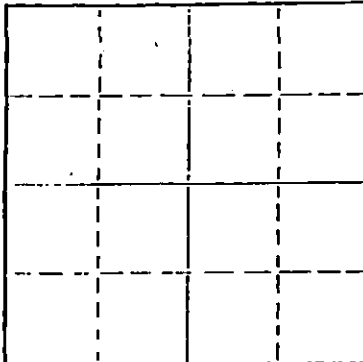

Locate well correctly on above
Section Plat

Sedgwick County. Sec. 1 Twp. 26 Rge. 1 (E) (W) X
Location as "NE/CNW/SW" or footage from lines NW/4 SE/4 NW/4
Lease Owner Bankoff Oil Co.
Lease Name Bright Well No. #7
Office Address Box 5, Pawnee Rock, Kansas
Character of Well (completed as Oil, Gas or Dry Hole) _____
Date well completed _____ 19____
Application for plugging filed _____ 19____
Application for plugging approved _____ 19____
Plugging commenced 3-1-76 19____
Plugging completed 3-8-76 19____
Reason for abandonment of well or producing formation _____

If a producing well is abandoned, date of last production _____ 19____
Was permission obtained from the Conservation Division or its agents before plugging was commenced? _____

Name of Conservation Agent who supervised plugging of this well Ted Dewey
Producing formation _____ Depth to top _____ Bottom _____ Total Depth of Well 3369' Feet
Show depth and thickness of all water, oil and gas formations.

OIL, GAS OR WATER RECORDS

CASING RECORD

FORMATION	CONTENT	FROM	TO	SIZE	PUT IN	PULLED OUT
				5 1/2"	3282'	Plug only
				12 1/2"	237'	

Describe in detail the manner in which the well was plugged, indicating where the mud fluid was placed and the method or methods used in introducing it into the hole. If cement or other plugs were used, state the character of same and depth placed, from _____ feet to _____ feet for each plug set.

Squeezed 8 5/8" casing inside and outside with 1/5 sacks cement from 200' to base of cellar.

RECEIVED
STATE CORPORATION COMMISSION

3-11-76
MAR 11 1976

CONSERVATION DIVISION
Wichita, Kansas

(If additional description is necessary, use BACK of this sheet)
Name of Plugging Contractor Southwest Casing Pulling Co.
Address Box 364 Great Bend, Kansas

STATE OF Kansas COUNTY OF Barton SS.
Southwest Casing Pulling Co. (employee of owner) or (owner or operator) of the above-described


well, being first duly sworn on oath, says: That I have knowledge of the facts, statements, and matters herein contained and the log of the above-described well as filed and that the same are true and correct. So help me God.

(Signature) W. C. Spencer Sec
Box 364 Great Bend, Kansas

Subscribed and Sworn to before me this 9 day of March 1976

My commission expires 24 October 1976

Sidney D. Miller
Notary Public

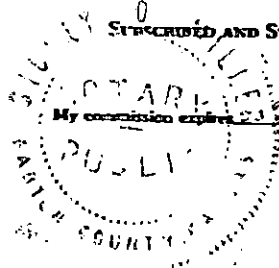

SAMUEL BRIGHT

WELL NO. 7

15-173-01834-0000

NW/4 SE/4 NW/4 Sec. 1, Twp. 26S, Range 1W
Sedgwick County, Kansas.

Well Started: 3/2/1930
Well Completed: 4/16/1930

Contractor: P. C. Perry
Owners: L. H. Wentz

CASING RECORD

15-1/2"	Cemt 160 Sx.	Wt. 70#	8Jts.	153'
12-1/2"	Cemt 237 sx.		11Jts.	223'
8-1/4"	Cemt			3282'
2-7/8"	Tubing		3302'	10"

FORMATION RECORD

153	Surface clay
215	Shale & shells
490	Lime
580	Lime & gypsum
705	Lime
795	Shale & lime
940	Lime & shale breaks
1080	Shale & lime
1210	Shale & shells
1340	Shale & lime shells
1440	Shale & shells
1530	Shale & lime
1620	Lime
1775	Shale & shells
1810	Shale & lime
1865	Lime
2085	Lime & shale breaks
2270	Shale
2330	Lime
2470	Shale & lime
2555	Shale & shells
2595	Lime & shale
2750	Lime - show oil 2620'
3005	Lime & shale
3030	Chat
3065	Hard sand and shells
3095	Lime & sand
3185	Lime
3194	Shale
3250	Lime
3336	Shale
3338	Sand - show oil & water - 1/2 oil & 1/2 water
3347	SLc
3338	TOTAL DEPTH
3369	Sandy Lime
3369	TOTAL DEPTH

REMARKS

TOTAL DEPTH 3369' -- Pay 3336-3369

IP 519 bbls. oil.

MAR 05 1976

Wichita, Kansas

60846