


15-173-01836-0000

WELL PLUGGING RECORD

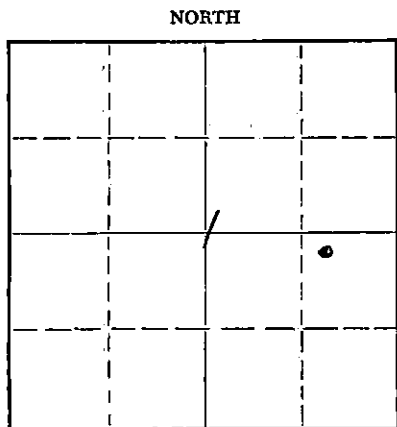

Locate well correctly on above
Section Plat

SEDSWICK County. Sec. 1 Twp. 26 Rge. 1 (E) W (W)
Location as "NE/CNW&SW" or footage from lines NW NE SE
Lease Owner S&S PIPE & SUPPLY CO
Lease Name Carr Well No. 2
Office Address P.O. Box 2513 TULSA, OKLA
Character of Well (completed as Oil, Gas or Dry Hole) OIL
Date well completed 5-30-29 19
Application for plugging filed 2-5-57 19
Application for plugging approved 2-5-57 19
Plugging commenced Mar 5 19 57
Plugging completed Mar. 9 19 57
Reason for abandonment of well or producing formation DEPLETED

If a producing well is abandoned, date of last production 19
Was permission obtained from the Conservation Division or its agents before plugging was commenced? Yes

Name of Conservation Agent who supervised plugging of this well Ruel Durkee
Producing formation K.C. LIME Depth to top 2562 Bottom 2602 Total Depth of Well 2630 Feet
Show depth and thickness of all water, oil and gas formations.

OIL, GAS OR WATER RECORDS

CASING RECORD

FORMATION	CONTENT	FROM	TO	SIZE	PUT IN	PULLED OUT
				15 1/2	176	NONE
				8 1/4"	3326	2173
				6 5/8	3336	3336

Describe in detail the manner in which the well was plugged, indicating where the mud fluid was placed and the method or methods used in introducing it into the hole. If cement or other plugs were used, state the character of same and depth placed, from feet to feet for each plug set.

Filled back to 2550'. Dumped 8 sacks of cement at 2550'.
Shot pipe off at 2173'. Pulled pipe and mudded hole to 170'.
Set rock bridge and dumped 40 sacks of cement. Finished
mudding hole and dumped 10 sacks of cement at base of cellar.

(If additional description is necessary, use BACK of this sheet)

Name of Plugging Contractor SELF
Address HUTCH. KANS

STATE OF Kans. Employee Reno, COUNTY OF ss.
(employee of owner) or (owner or operator) of the above-described well, being first duly sworn on oath, says: That I have knowledge of the facts, statements, and matters herein contained and the log of the above-described well as filed and that the same are true and correct. So help me God.

(Signature) Ruel Durkee
R. R. #4, Hutchinson, Kans. (Address)

SUBSCRIBED AND SWORN TO before me this 11th day of Mar. 19 57

My commission expires August 12, 1957 Notary Public.

PLUGGING
FILE SEC 1 T. 26 R. 1W
BOOK PAGE 138 LINE 45

APR 1 - 1957
CONSERVATION DIVISION
Wichita, Kansas

Completion Report, Corr #2, located 990' West Of East Line and 330'

South of North line, SE $\frac{1}{4}$ -Section 1 -T26S-R1W, Sedgwick County Kansas.

Contractor-Lofflan Bros. Rotary Tools.

Date Spudded-4-21-29

Date Of Completion-5-30-29

Actual Depth-3366'

Initial Production - 316 Barrels 6 Hours.

Top Of Dolomite-3360'

15-173-01836-0000

<u>Nature Of Strata.</u>	<u>From.</u>	<u>To.</u>	<u>Remarks.</u>
Surface	0	70	
Broken Lime	70	176	
Sand	176	276	
Lime	276	651	
Shale	651	810	
Broken Lime	810	891	
Shale	891	1041	
Shale	1041	1181	
Shale & Shells	1181	1321	
Broken Lime	1321	1651	
Shale & Shells	1651	1731	
Shale	1731	1751	
Lime	1751	1790	
Shale	1790	1925	
Broken Lime	1925	2020	
Shale	2020	2055	
Broken Lime	2055	2135	
Shale	2135	2265	
Broken Lime	2265	2320	
Lime	2320	2500	
Shale & Shells	2500	2570	
Broken Lime	2570	2620	
Shale & Shells	2620	2690	
Broken Lime	2690	2775	
Shale	2775	2820	
Shale & Shells	2820	2875	
Broken Lime & Shale	2875	2915	
Shale	2915	2970	
Broken Lime & Shale	2970	3020	
Broken Lime	3020	3195	
Lime	3195	3220	
Shale & Lime	3220	3255	
Shale	3255	3280	
Shale	3280	3326	
Black Lime & White Shale	3326	3336	
Shale	3336	3360	
Sand	3360	3366	
Total Depth		3366	

Casing Record.

<u>Size.</u>	<u>Weight.</u>	<u>Amt Run.</u>	<u>Amt Pulled.</u>	<u>Amt Left In.</u>	<u>Sacks Cement Used.</u>
15 $\frac{1}{2}$ "	70#	176'	None	176'	200 Sax. 200# C.C.
8 $\frac{1}{2}$ "	32#	3326'	None	3326'	400 Sax
6-5/8"	24#	3336'	None	3336'	None

RECEIVED
STATE CORPORATION COMMISSION

APR 1 - 1957

CONSERVATION DIVISION
Wichita, Kansas

