

STATE OF KANSAS
STATE CORPORATION COMMISSION


WELL PLUGGING RECORD
OR
FORMATION PLUGGING RECORD

Strike out upper line
when reporting plug-
ging off formations.

Give All Information Completely
Make Required Affidavit
Mail or Deliver Report to:
Conservation Division
State Corporation Commission
800 Bittling Building
Wichita, Kansas

Kiowa County, Sec 9 Twp 27SRge (E) 16 (W)

NORTH R-16W

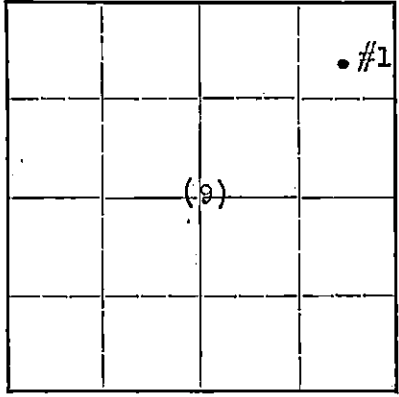

Locate well correctly on above
Section Plat

Location as "NE 1/4 NW 1/4 SW 1/4" or footage from lines
Lease Owner Stanolind Oil and Gas Company
Lease Name Rinda Williams Well No. 1
Office Address Box 591, Tulsa, Oklahoma
Character of Well (completed as Oil, Gas or Dry Hole) Dry Hole
Date well completed December 16th, 1942
T Application for plugging filed verbal December 18th, 1942
27 Application for plugging approved December 18th, 1942
S Plugging commenced December 19th, 1942
Plugging completed December 19th, 1942
Reason for abandonment of well or producing formation non-productive

If a producing well is abandoned, date of last production 19
Was permission obtained from the Conservation Division or its agents before plugging was com-
menced? yes

Name of Conservation Agent who supervised plugging of this well C. T. Alexander
Producing formation Arbuckle Depth to top 4827 Bottom 4877 Total Depth of Well 4877 Feet
Show depth and thickness of all water, oil and gas formations.

OIL, GAS OR WATER RECORDS


CASING RECORD

Formation	Content	From	To	Size	Put In	Pulled Out
Lansing Lime	Dry	4024				
Viola Lime	Dry	4666				
Simpson	Dry	4743				
Arbuckle	Dry	4827	4877			

Describe in detail the manner in which the well was plugged, indicating where the mud fluid was placed and the method or methods used in introducing it into the hole. If cement or other plugs were used, state the character of same and depth placed, from feet to feet for each plug set.

Total Depth 4877'

Heavy mud 4877 to 586
Wood Plug 586 to 585
15 sacks cement 585 to 541
Heavy mud 541 to 47
15 sacks cement 47 to 7
soils 7 to surface

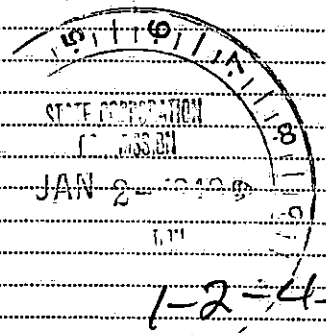

(If additional description is necessary, use BACK of this sheet)
Correspondence regarding this well should be addressed to Stanolind Oil and Gas Company
Address Box 591, Tulsa, Oklahoma

STATE OF KANSAS, COUNTY OF STAFFORD, ss.

C. B. Snyder (employee of owner) or (owner or operator) of the above-described well,
being first duly sworn on oath, says: That I have knowledge of the facts, statements, and matters herein contained and the log of the above-
described well as filed and that the same are true and correct. So help me God.

(Signature) C. B. Snyder, Field Supt.
Route No. 2, Stafford, Kansas (Address)

SUBSCRIBED AND SWORN TO before me this 29th day of December, 1942.
George A. Banks, Notary Public.

My commission expires Feb. 6, 1946