

STATE OF KANSAS
STATE CORPORATION COMMISSION

Give All Information Completely
Make Required Affidavit
Mail or Deliver Report to:
Conservation Division
State Corporation Commission
211 No. Broadway
Wichita, Kansas

WELL PLUGGING RECORD

Kiowa County. Sec. 9 Twp. 27 Rge. 16 (E) W. (W)

Location as "NE/CNW/SW" or footage from lines. NE NE NE

Lease Owner Jones & Campbell, Inc.

Lease Name Baker Well No. 1

Office Address 2500 Johnson Drive, Shawnee Mission, Kansas

Character of Well (completed as Oil, Gas or Dry Hole) dry

Date well completed 19

Application for plugging filed Sept. 5 1962

Application for plugging approved Sept. 5 1962


Plugging commenced 9-5 1962

Plugging completed 9-10 1962

Reason for abandonment of well or producing formation dry

If a producing well is abandoned, date of last production 19

Was permission obtained from the Conservation Division or its agents before plugging was commenced? yes

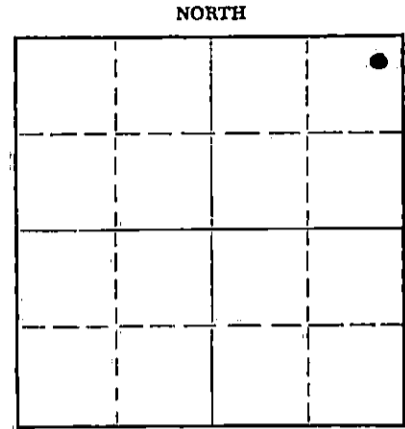

Locate well correctly on above Section Plat

Name of Conservation Agent who supervised plugging of this well W. L. Lackamp

Producing formation Depth to top Bottom Total Depth of Well 4878 Feet

Show depth and thickness of all water, oil and gas formations.

OIL, GAS OR WATER RECORDS

CASING RECORD

FORMATION	CONTENT	FROM	TO	SIZE	PUT IN	PULLED OUT
				8 5/8	585 570	none
				5 1/2	4876	3771

Describe in detail the manner in which the well was plugged, indicating where the mud fluid was placed and the method or methods used in introducing it into the hole. If cement or other plugs were used, state the character of same and depth placed, from feet to feet for each plug set.

Plugged back with sand from 4628' to 4510'. Mixed and dumped 5 sx. cement from 4510' to 4470'.
Pulled 3771' of 5 1/2" casing.
Mudded hole to 360'. Set 10' rock bridge from 360' to 350'. Mixed and dumped 20 sx. cement from 350' to 290'. Mudded hole to 100'.
Let set over night. Mudded hole to 35'. Set 5' rock bridge from 35' to 30'. Mixed and dumped 10 sx. cement from 30' to base of cellar.

RECEIVED
STATE CORPORATION COMMISSION

SEP 17 1962

CONSERVATION DIVISION
Wichita, Kansas

(If additional description is necessary, use BACK of this sheet)

Name of Plugging Contractor Ace Pipe Pulling Company License # 2

Address Box 304 Great Bend, Kansas

STATE OF Kansas, COUNTY OF Barton, ss.
Wm. D. Hoberecht (emp.) (employee of owner) or (owner or operator) of the above-described well, being first duly sworn on oath, says: That I have knowledge of the facts, statements, and matters herein contained and the log of the above-described well as filed and that the same are true and correct. So help me God.

(Signature) W. D. Hoberecht
Great Bend, Ks.
(Address)

SUBSCRIBED AND SWORN TO before me this 14th day of September, 1962.

My commission expires March 1, 1966 Notary Public.



JONES AND CAMPBELL, INC.

Baker #1 (Old welll workover)
NE NENE Sec. 9-27S-16W
Kiowa county, Kans.

Elev. 2089 GL.

Surface casing 8 5/8" at 585'

FORMATION TOPS (Log)

Anhydrite	1010
Heebner	3854
Br. Lime	4004
Lansing	4024
Cherokee Sd	4493
Miss. Chert	4517
Kinderhook Sd.	4546
Viola	4616
Simpson	4749
Arbuckle	4830
T.D.	4877

RECEIVED
STATE CORPORATION COMMISSION
SEP. 17 1962
CONSERVATION DIVISION
Wichita, Kansas