


STATE OF KANSAS
STATE CORPORATION COMMISSION

Form CP-4

Give All Information Completely
Make Required Affidavit
Mail or Deliver Report to:
Conservation Division
State Corporation Commission
212 No. Market
Wichita, Kansas

WELL PLUGGING RECORD

NORTH

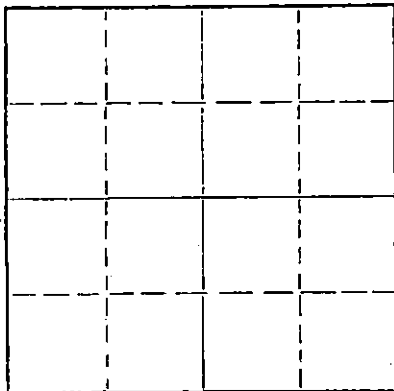Locate well correctly on above
Section Plat

PRATT

County. Sec. 35 Twp. 29S Rge. 13W (E) (W)

Location as "NE/CNW/SW" or footage from lines NW NE NW

Lease Owner SANTA-FE PIPE & SUPPLY, INC.

Lease Name LARRISON "A"

Well No. 2

Office Address BOX 562, GREAT BEND, KANSAS

Character of Well (completed as Oil, Gas or Dry Hole) GAS WELL

Date well completed APRIL 26 19 59

Application for plugging filed MARCH 24 19 67

Application for plugging approved MARCH 27 19 67

Plugging commenced MARCH 25 19 67

Plugging completed MARCH 31 19 67

Reason for abandonment of well or producing formation DEPLETED

If a producing well is abandoned, date of last production 19

Was permission obtained from the Conservation Division or its agents before plugging was commenced? YES

Name of Conservation Agent who supervised plugging of this well

MR. ARCHIE ELVING

Producing formation Depth to top Bottom Total Depth of Well 4600 Feet

Show depth and thickness of all water, oil and gas formations.

OIL, GAS OR WATER RECORDS

CASING RECORD

FORMATION	CONTENT	FROM	TO	SIZE	PUT IN	PULLED OUT
				8 5/8	852	NONE
				5 1/2	4599	4143

Describe in detail the manner in which the well was plugged, indicating where the mud fluid was placed and the method or methods used in introducing it into the hole. If cement or other plugs were used, state the character of same and depth placed, from feet to feet for each plug set.

4600 - 4571 - PLUG

4571 - 4525 - SAND

4525 - 4485 - 5 SACKS CEMENT

4485 - 400 - MUD

400 - 385 - ROCK BRIDGE

385 - 310 - 25 SACKS CEMENT

310 - 40 - MUD

40 - 30 - ROCK BRIDGE

30 - BASE - 10 SACKS CEMENT

RECEIVED
STATE CORPORATION COMMISSIONAPR 17 1967
04-17-67CONSERVATION DIVISION
WICHITA, KANSAS

Name of Plugging Contractor

(If additional description is necessary, use BACK of this sheet)

SANTA-FE PIPE & SUPPLY, INC.

Address

BOX 562, GREAT BEND, KANSAS

STATE OF KANSAS, COUNTY OF BARTON, ss.

T.L. NUTT

XXXXXXXXXX

well, being first duly sworn on oath, says: That I have knowledge of the facts, statements, and matters herein contained and the log of the above-described well as filed and that the same are true and correct. So help me God.

(Signature)

BOX 562, GREAT BEND, KANSAS

(Address)

SUBSCRIBED AND SWORN TO before me this 11 day of APRIL, 1967

My commission expires

JULY 31, 1970

MARY M. GUESNIER

Notary Public.

WELL LOG BUREAU—KANSAS GEOLOGICAL SOCIETY
50S East Murdock, Wichita, Kansas


Company. NATURAL GAS & OIL CO.
Farm. Larrison "A" No. 2

SEC. 35 T. 29 R. 13W
NW NE NW

Total Depth. 4600'
Comm. 4-3-59 Comp. 4-26-59
Shot or Treated.
Contractor. Sierra Petroleum Co.
Issued. 7-4-59

County Pratt

KANSAS

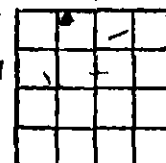

Elevation. 1863' KB

Production. 2,300,000 CFG.

CASING:

8 5/8" 852' cem w/600 sx.
5 1/2" 4599' cem w/170 sx.

Figures indicate Bottom of Formations.

sand & clay	140
shale	240
shale & red bed	375
red bed	749
Anhydrite	770
shale & red bed	852
shale & shells	1235
shale & shells	1480
salt & shale	1615
shale & shells	1865
lime	2405
shale & lime	3080
lime	3300
lime & shale	3485
lime	3775
lime & shale	3879
lime	4331
lime & shale	4307
Viola	4420
lime	4435
chert, lime & shale	4474
lime & shale	4503½
lime	4538
Simpson sand	4600
Total Depth	

TOPS:

Heebner (scout)	3670
Douglas (scout)	3705
Lansing (scout)	3864
Conglomerate (scout)	4289
Misner Sand (scout)	4387
Viola (scout)	4397
Simpson Shale	4512
Simpson Sand	4533

RECEIVED
STATE CORPORATION COMMISSION
MAR 27 1967
CONSERVATION DIVISION
Wichita, Kansas