


STATE OF KANSAS  
STATE CORPORATION COMMISSION

Form CP-4

Give All Information Completely  
Make Required Affidavit  
Mail or Deliver Report to:  
Conservation Division  
State Corporation Commission

WELL PLUGGING RECORD

P. O. Box 17027  
Wichita, Kansas 67217  
NORTH

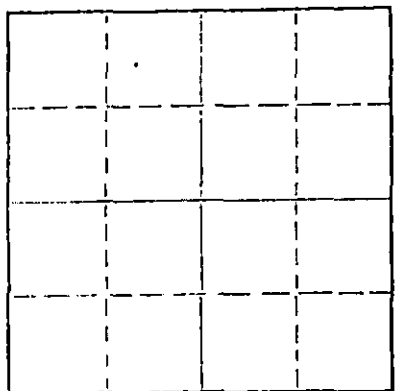

Locate well correctly on above  
Section Plat

Pratt County, Sec. 34 Twp. 29S Rge. 13 (E) (W)  
Location as "NE/CNW&SW" or footage from lines 1650' FSL 330' FEL  
Lease Owner Cities Service Oil Company  
Lease Name Keyes "A" Well No. #2  
Office Address 209 E. William, 700 Sutton Pl. Bldg. Wichita, Kansas  
Character of Well (completed as Oil, Gas or Dry Hole) Dry Well  
Date well completed 1-11 19 74  
Application for plugging filed 1-11 19 74  
Application for plugging approved 1-11 19 74  
Plugging commenced 1-11 19 74  
Plugging completed 1-11 19 74  
Reason for abandonment of well or producing formation Dry Well

If a producing well is abandoned, date of last production 19  
Was permission obtained from the Conservation Division or its agents before plugging was commenced? Yes

Name of Conservation Agent who supervised plugging of this well G. Russel Biberstein  
Producing formation \_\_\_\_\_ Depth to top \_\_\_\_\_ Bottom \_\_\_\_\_ Total Depth of Well 4685 Feet  
Show depth and thickness of all water, oil and gas formations.


OIL, GAS OR WATER RECORDS

CASING RECORD

FORMATION	CONTENT	FROM	TO	SIZE	PUT IN	PULLED OUT
				8 5/8"	1020'	None
				12 1/4"	933'	None

Describe in detail the manner in which the well was plugged, indicating where the mud fluid was placed and the method or methods used in introducing it into the hole. If cement or other plugs were used, state the character of same and depth placed, from \_\_\_\_\_ feet to \_\_\_\_\_ feet for each plug set.

Spot heavy mud 4685-350. Plug 1/2 sack hulls, 35 sacks cement, 350-210.  
Heavy mud 210-50. Plug 1/2 sack hulls, 15 sacks cement 50' to base of cellar,  
5 sacks cement in rat hole.

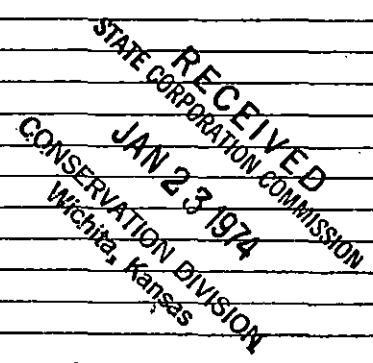

Name of Plugging Contractor Gabbert & Jones, Inc.  
Address 830 Sutton Place Wichita, Kansas 67202

STATE OF Kansas, COUNTY OF Sedgwick, ss. W. J. Devaney

(employee of owner) or (owner or operator) of the above-described well, being first duly sworn on oath, says: That I have knowledge of the facts, statements, and matters herein contained and the log of the above-described well as filed and that the same are true and correct. So help me God.

DEAN CALDWELL  
State Notary Public  
Sedgwick County, Kansas  
Comm. Expires Oct. 16, 1977

(Signature) \_\_\_\_\_  
209 E. William, 700 Sutton Pl. Bldg. Wichita, KS  
(Address) 67202

SUBSCRIBED AND SWORN TO before me this 21st day of January, 19 74

Dean Caldwell  
Notary Public.

GABBERT-JONES, INC.  
 WICHITA, KANSAS  
 DRILLERS' WELL LOG

RECEIVED  
 STATE CORPORATION COMMISSION  
 APR 5 - 1974  
 CONSERVATION DIVISION  
 Wichita, Kansas

KEYES "A" #2  
 SE NE SE  
 Section 34-29S-13W  
 Pratt County, Kansas

Commenced: December 21, 1973  
 Completed: January 11, 1974

OPERATOR: CITIES SERVICE OIL CO.

From	Depth To	Formation	Remarks
0	70	Shale-sand	Ran 4 jts of 13 3/8" csg. set @ 125'
70	95	Sand	w/250 sks 50/50 Posmix - 14# Gilsonite
95	126	Redbed	per sack
126	180	Redbed-sand	P.D. @ 10:45 AM 12/23/1973 Cement Circ.
180	260	Redbed	
260	650	Shale-redbed-shells	Ran 24 jts of new 20# 8 5/8" csg. set
650	1755	Shale-shells	@ 1019' w/250 sks Lite 10# Gilsonite
1755	3105	Lime-shale	1/2# Flow Seal per sack - 3% CC, 100
3105	3290	Lime	sks common, 1/4# Flow Seal per Sack
3290	3830	Lime-shale	3% CC
3830	4290	Lime	P.D. @ 8:05 PM 12/27/1973
4290	4365	Shale-sand	Cement Circ.
4365	4385	Lime	
4385	4412	Chert-lime	
4412	4520	Lime	
4520	4578	Sand-lime	
4578	4586	Shale-lime	
4586	4685	(Arb.) Lime	
4685		TD	DRY AND ABANDONED

I, James S. Sutton, II, certify this is a correct copy of the Drillers' Log for the above described location in Pratt County, Kansas, to the best of my knowledge and belief.

*James S. Sutton, II*  
 James S. Sutton, II

STATE OF KANSAS )  
 ) SS  
 COUNTY OF SEDGWICK )

Before me, the undersigned, a Notary Public within and for said County and State, on this 14th day of January, 1974, personally appeared James S. Sutton, II, to me personally known to be the identical person who executed the within and foregoing instrument and acknowledged to me that he executed the same as his free and voluntary act and deed for the uses and purposes therein set forth.

IN WITNESS WHEREOF, I have hereunto set my hand and official seal the day and year last above written.

*Marjorie Hall*  
 Marjorie Hall, Notary Public

My Commission expires Nov. 29, 1975

