


STATE OF KANSAS
STATE CORPORATION COMMISSION

15-57-20240-0000

WELL PLUGGING RECORD

Give All Information Completely
Make Required Affidavit
Mail or Deliver Report to
Conservation Division
State Corporation Comm.
245 North Water
Wichita, KS 67202

Ford County. Sec. 29 Twp. 28S Rge. 21W E/W
Location as "NE/CNW $\frac{1}{4}$ SW $\frac{1}{4}$ " or footage from lines
C NE/4

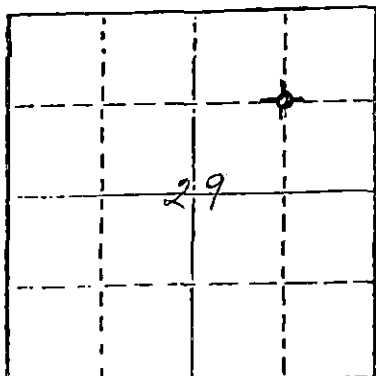

Locate well correctly on above
Section Plot

Lease Owner Lee Banks (Banks Oil Company)
Lease Name Marshrey Well No. 1
Office Address 200 W. Douglas, Suite 550, Wichita, KS 67202
Character of Well (Completed as Oil, Gas or Dry Hole)
Dry Hole

Date Well completed September 1, 1981
Application for plugging filed September 1, 1981
Application for plugging approved September 1, 1981
Plugging commenced September 1, 1981
Plugging completed September 1, 1981
Reason for abandonment of well or producing formation
Dry Hole

If a producing well is abandoned, date of last production
19

Was permission obtained from the Conservation Division or
its agents before plugging was commenced? Yes

Name of Conservation Agent who supervised plugging of this well Clarence Thomas, Jr.
Producing formation _____ Depth to top _____ Bottom _____ Total Depth of Well 5180'
Show depth and thickness of all water, oil and gas formations.

OIL, GAS OR WATER RECORDS

CASING RECORD

FORMATION	CONTENT	FROM	TO	SIZE	PUT IN	PULLED OUT
		0'	629'	8-5/8"	622.87'	None

Describe in detail the manner in which the well was plugged, indicating where the mud fluid was placed and the method or methods used in introducing it into the hold. If cement or other plugs were used, state the character of same and depth placed, from _____ feet to _____ feet for each plug set.

Plugged with 60 sacks cement at 660';
40 sacks cement at 330'; 10 sacks cement
and plug at 40'; 10 sacks cement in
rat hole.

RECEIVED
STATE CORPORATION COMMISSION
SEP 15 1981
CONSERVATION DIVISION
Wichita, Kansas

(If additional description is necessary, use BACK of this sheet)
Name of Plugging Contractor Allied Cementing Co.


STATE OF KANSAS COUNTY OF SEDGWICK, ss.
John D. Knightley, Agent (employee of owner) or (owner or operator)
of the above-described well, being first duly sworn on oath, says: That I have knowledge of
the facts, statements, and matters herein contained and the log of the above-described well
as filed, and that the same are true and correct. So help me God.

(Signature) [Signature]
221 S. Broadway, Suite 400, Wichita, KS 67202
(Address)

SUBSCRIBED AND SWORN TO before me this 14th day of September, 1981

[Signature]
Notary Public.

My commission expires March 12, 1983

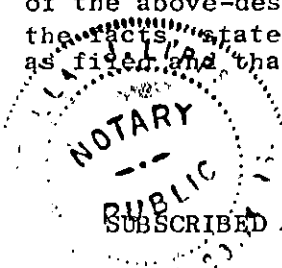

15-57-26240-0000

Lee Banks,
Banks Oil Company -
200 W. Douglas, Suite 550
Wichita, Kansas 67202

Marshrey #1
C NE/4 Sec. 29-28S-21W
Ford County, Kansas

Contractor: D. R. Lauck Oil Company, Inc.
221 S. Broadway, Suite 400
Wichita, Kansas 67202

Commenced: August 21, 1981
Completed: September 1, 1981

Drillers Log

Sand, Clay	430
Clay, Red Bed	1070
Shale	1790
Red Bed, Shale	2196
Shale	3140
Shale & Lime	3375
Lime & Shale	3565
Shale & Lime	4315
Lime & Shale	4425
Lime	5180 RTD

RECEIVED
STATE CORPORATION COMMISSION
SEP 15 1981
CONSERVATION DIVISION
Wichita, Kansas