


STATE OF KANSAS
STATE CORPORATION COMMISSION

WELL PLUGGING RECORD

Give All Information Completely
Make Required Affidavit
Mail or Deliver Report to
Conservation Division
State Corporation Comm.
245 North Water
Wichita, KS N 67202

Stanton County. Sec. 20 Twp. 27 Rge. 10 E/W
Location as "NE/CNW 1/4 SW 1/4" or footage from lines
E C SE 1/4
Lease Owner Beren Corporation
Lease Name Nicholas Farms Well No. 1
Office Address 970 14th Financial Center, Wichita, Ks.
Character of Well (Completed as Oil, Gas or Dry Hole)
Gas
Date Well completed Jan. 31, 1976 19
Application for plugging filed July 16, 1976
Application for plugging approved July 18, 1976
Plugging commenced Oct. 15, 1976
Plugging completed Oct. 16, 1976
Reason for abandonment of well or producing formation
Non Comercial Value
If a producing well is abandoned, date of last production
19

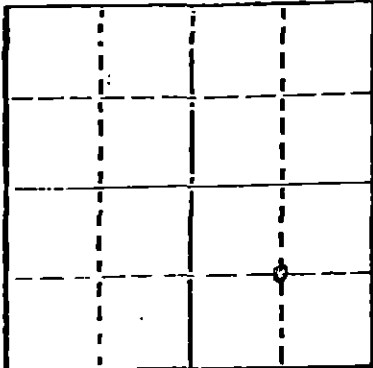

Locate well correctly on above
Section Plat

Was permission obtained from the Conservation Division or
its agents before plugging was commenced? Yes

Name of Conservation Agent who supervised plugging of this well Mr. Thomas
Producing formation Hugoton Depth to top 2492' Bottom 2496' Total Depth of Well 2731'
Show depth and thickness of all water, oil and gas formations.

OIL, GAS OR WATER RECORDS

CASING RECORD

FORMATION	CONTENT	FROM	TO	SIZE	FEET IN	PULLED OUT
Surface		0'	390'	10"	390'	0'
Intermediate		0'	2299'	7"	2299'	0'
Hugoton		0'	2730'	4 1/2"	2730'	2118'

Describe in detail the manner in which the well was plugged, indicating where the mud fluid
was placed and the method or methods used in introducing it into the hold. If cement or other
plugs were used, state the character of same and depth placed, from _____ feet to
_____ feet for each plug set.

Pumped 1 sack of hulls & 10 sacks cement to 2280' Pressured to 500#.
Displaced w/ 5 sacks gel.
Pumped 25 sacks cement 1800' to 1700'-Displaced w/ 4 sacks gel.
Put bridge & 10 sacks cement 40' to 0'.
Cut 10" & 7" to 3' below ground level.

NOV 04 1978 15-187-00154-0001

CONCERNED PUBLIC
WICHITA, KANSAS

(If additional description is necessary, use BACK of this sheet)

Name of Plugging Contractor Midwest Casing Pulling
Box F, Sublette, Kansas 67877 Permit # 766


STATE OF Kansas COUNTY OF Haskell ss.
Edgar J. Eves

(employee of owner) or (owner or operator) of the above-described
well being first duly sworn on oath, says: That I have knowledge of the facts, statements and matters herein contained and the log of the
above-described well as filed and that the same are true and correct. So help me God.

(Signature) Edgar J. Eves
Box F, Sublette, Kansas 67877
(Address)

Sworn to before me this 19 day of October 1976

Greta G. Pilsand
Notary Public.

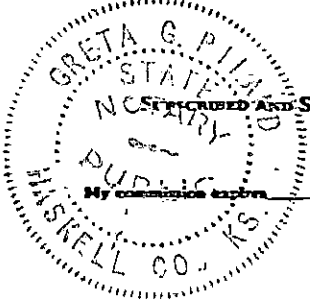

My commission expires 2-16-78