


STATE OF KANSAS
STATE CORPORATION COMMISSION

WELL PLUGGING RECORD

Give All Information Completely
Make Required Affidavit
Mail or Deliver Report to:
Conservation Division
State Corporation Commission
800 Biting Building
Wichita, Kansas

NORTH

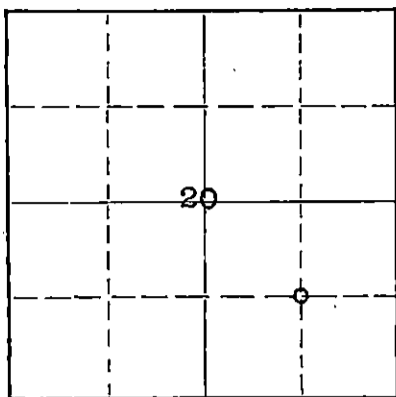

Locate well correctly on above
Section Plat

Stanton County. Sec. 20 Twp. 27 Rge. 40 NE W (W)
Location as "NE/CNW/SW" or footage from lines Center of SE/4
Lease Owner Northern Pump Company
Lease Name Winger Well No. 1
Office Address Box 94, Great Bend, Kansas
Character of Well (completed as Oil, Gas or Dry Hole) Gas
Date well completed August 7 1957
Application for plugging filed March 7 1958
Application for plugging approved March 10 1958
Plugging commenced March 19 1958
Plugging completed March 19 1958
Reason for abandonment of well or producing formation Dry

If a producing well is abandoned, date of last production None 19
Was permission obtained from the Conservation Division or its agents before plugging was commenced? Yes

Name of Conservation Agent who supervised plugging of this well Merle Rives
Producing formation Herington & Winfield Depth to top 2222 Bottom 2276 Total Depth of Well 2300 Feet
Show depth and thickness of all water, oil and gas formations.

OIL, GAS OR WATER RECORDS

CASING RECORD

FORMATION	CONTENT	FROM	TO	SIZE	PUT IN	PULLED OUT
Herington	16'	2222	2238	10-3/4"	390'	None
Winfield	10'	2266	2276	7"	2299'	None

Describe in detail the manner in which the well was plugged, indicating where the mud fluid was placed and the method or methods used in introducing it into the hole. If cement or other plugs were used, state the character of same and depth placed, from _____ feet to _____ feet for each plug set.

Pump 15 sacks cement 2175' to 2220'
Mud up to 500'
Pump 25 sacks cement 375' to 500'
Mud up to 25'
Set cement plug to base of cellar.
Cement and mud pumped in by Halliburton Oil Well Cementing Company.

(If additional description is necessary, use BACK of this sheet)
Name of Plugging Contractor Northern Pump Company & HOWCO
Address Box 94, Great Bend, Ks.


STATE OF KANSAS, COUNTY OF BARTON, ss.
Chas. J. Beu (employee of owner) or (owner or operator) of the above-described well, being first duly sworn on oath, says: That I have knowledge of the facts, statements, and matters herein contained and the log of the above-described well as filed and that the same are true and correct. So help me God.

(Signature) Chas. J. Beu
Chas. J. Beu, General Manager
Box 94, Great Bend, Kansas (Address)

SUBSCRIBED AND SWORN TO before me this 20th day of March, 1958

Claudine Turner
Claudine Turner Notary Public.

My commission expires January 28, 1959

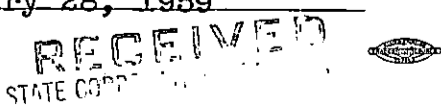

3-21-58

MAR 21

PLUGGING	
FILE SEC	<u>22 T. 27 R. 40</u>
BOOK PAGE	<u>88</u> LINE <u>1</u>

Contractor:
Garvey Drilling Company
Route 2
Great Bend, Kansas

Company:
Northern Pump Company
Winger #1
Center of SE/4
Sec. 20-T27S-R40W
Stanton County, Ks.

TOTAL DEPTH: 2300'
Commenced: April 13, 1957
Completed: August 7, 1957
Casing: 390' - 10-3/4" Casing - Cement w/325 Sacks
2299' - 7" Casing - Cement w/600 Sacks

Figures indicate bottom of formation:

Clay and Shale	0 - 90
Shale	595
Sand & Redbed	1700
Anhydrite	1710
Redbed & Shells	2010
Shale and Shells	2115
Lime & Redbed	2230
Lime and Shale	2300 - Rotary T.D.

Elevation:	Ground	3268'
	D.F.	3270'
	K.B.	3273'

Geological Tops:	Base of Stone Corral	1715	/1558
	Herington	2222-2238	/1051
	Krider	2238-2254	/1035
	Winfield	2266	/1007
	T.D.	2300	/ 973

FILE
STAT CORRAL

MAR 8 1958

CONSERVATION DIVISION
Wichita, Kansas

PLUGGING
FILE SEC 20 T.27 R. 40W
BOOK PAGE 88 LINE 1