

STATE OF KANSAS  
STATE CORPORATION COMMISSION

WELL PLUGGING RECORD

Give All Information Completely  
Make Required Affidavit  
Mail or Deliver Report to:  
Conservation Division  
State Corporation Commission  
800 Bittling Building  
Wichita, Kansas

Stanton County, Sec. 20 Twp. 27 Rge. 40 (E) W (W)

Location as "NE/CNW/SW" or footage from lines Center - 150' S&E

Lease Owner United Producing Company

Lease Name United Producing Co-M.L.Winger Well No. 1

Office Address Satanta, Kansas.

Character of Well (completed as Oil, Gas or Dry Hole) Dry hole

Date well completed 19

Application for plugging filed 19

Application for plugging approved 19

Plugging commenced October 22, 1953 19


Plugging completed Oct. 27, 1953. 19

Reason for abandonment of well or producing formation

Completed as dry hole

If a producing well is abandoned, date of last production 19

Was permission obtained from the Conservation Division or its agents before plugging was commenced? yes

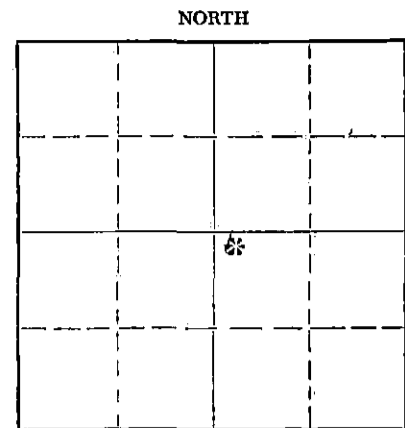

Locate well correctly on above Section Plat

Name of Conservation Agent who supervised plugging of this well Merle Rives

Producing formation Depth to top Bottom Total Depth of Well 2284 Feet

Show depth and thickness of all water, oil and gas formations.

OIL, GAS OR WATER RECORDS

CASING RECORD

FORMATION	CONTENT	FROM	TO	SIZE	PUT IN	PULLED OUT

Describe in detail the manner in which the well was plugged, indicating where the mud fluid was placed and the method or methods used in introducing it into the hole. If cement or other plugs were used, state the character of same and depth placed, from 2284 feet to surface feet for each plug set.

Hole filled with cement and previously plugged back from 2284 to 2100 feet; Hole filled with mud from 2100 ft to 375 ft. Ten foot rock bridge installed between 375 feet and 365 feet; ~~xxxx~~ Twenty sacks of cement placed on top of rock bridge and hole filled with mud to thirty feet; five foot rock bridge installed between 30 and 25 feet; ten sacks of cement placed on top of bridge. plugging complete.

This Record is supplement to Previous record made out Oct. 12, 1951.

Name of Plugging Contractor Barnes & Sons Pipe Pulling Co. (If additional description is necessary, use BACK of this sheet)  
Address Russell, Kansas

STATE OF Kansas, COUNTY OF Haskell, ss.  
Arthur H. Robinson (employee of owner) or (owner or operator) of the above-described well, being first duly sworn on oath, says: That I have knowledge of the facts, statements, and matters herein contained and the log of the above-described well as filed and that the same are true and correct. So help me God.

(Signature) Arthur H. Robinson  
Satanta, Kansas (Address)

SUBSCRIBED AND SWORN TO before me this 13th day of November, 1953.

William B. Claunch Notary Public.

My commission expires August 30, 1956


PLUGGING  
FILE SEC 20 T 27 R 40W  
BOOK PAGE 114 LINE 4

RECEIVED  
NOV 16 1953 11-16-53  
CONSERVATION DIVISION  
Wichita, Kansas

Well Log  
Mary L. Winger, Well #1  
Stanton County, Kansas

00 - 265' Sand & Gravel  
265 - 340' Sandy clay  
340 - 409' Blue Shale  
409 - 910' Red Bed & Shale  
910 - 1182' Red Bed, Gyp, Shale  
1182 - 1590' Red Bed, & Shale  
1590 - 1695' Anhydrite, shale & gyp  
1695 - 1700' Gyp  
1700 - 1720' Anhydrite  
1720 - 1740' Red Bed  
1740 - 1760' Anhydrite  
1760 - 1799' Shale & Anhydrite  
1799 - 2010' Red Bed & Anhydrite  
2010 - 2104' Anhydrite & Shale  
2104 - 2226' Anhydrite & Lime  
  
2226 - 2240' Lime  
2240 - 2248' Lime  
2248 - 2262' Sandy Red & Blue Shale  
2262 - 2274' Shale  
2274 - 2282' Lime  
2282 - 2284' Shale

Set & Cemented 10 3/4" OD Casing at 399' (250sx)  
Set & Cemented 6 5/8" OD Casing at 2226' (500 SX)  
Began Drilling April 21, 1951

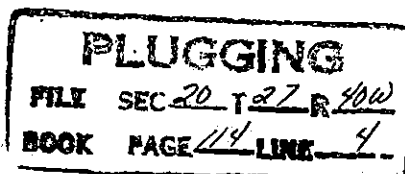

STATE OF KANSAS  
NOV 1 1955  
CONSERVATION DIVISION  
Wichita, Kansas