


STATE OF KANSAS
STATE CORPORATION COMMISSION

Give All Information Completely
Make Required Affidavit
Mail or Deliver Report to:
Conservation Division
State Corporation Commission
800 Bitting Building
Wichita, Kansas

WELL PLUGGING RECORD

Stanton County, Sec. 3 Twp. 27S Rge. (E) 40(W)
Location as "NE/CNW/SW" or footage from lines G. NE/4
Lease Owner Wm. Graham Oil Company
Lease Name Jacquart Well No. 1
Office Address P. O. Box 1033

NORTH

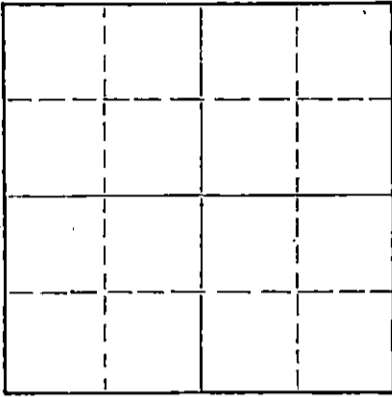

Locate well correctly on above
Section Plat

Character of Well (completed as Oil, Gas or Dry Hole) Dry Hole
Date well completed 12-4-54 19
Application for plugging filed 12-4-54 Verbal 19
Application for plugging approved 12-4-54 Verbal 19
Plugging commenced 12-4-54 19
Plugging completed 12-4-54 19
Reason for abandonment of well or producing formation Acidized -
No results - Found salt water
If a producing well is abandoned, date of last production 19
Was permission obtained from the Conservation Division or its agents before plugging was com-
menced? Yes

Name of Conservation Agent who supervised plugging of this well M. A. Rives
Producing formation _____ Depth to top _____ Bottom _____ Total Depth of Well 2376 Feet
Show depth and thickness of all water, oil and gas formations.

OIL, GAS OR WATER RECORDS

CASING RECORD

FORMATION	CONTENT	FROM	TO	SIZE	PUT IN	PULLED OUT
				8 5/8	401	- - -
				5 1/2	2312	- - -

Describe in detail the manner in which the well was plugged, indicating where the mud fluid was placed and the method or methods used in introducing it into the hole. If cement or other plugs were used, state the character of same and depth placed, from _____ feet to _____ feet for each plug set.

Plugged with 300 sacks cement
3' nipple on top above ground with end
welded solid.

(If additional description is necessary, use BACK of this sheet)

Name of Plugging Contractor _____ 1-13-55
Address _____


STATE OF Kansas, COUNTY OF Sedgwick, ss.
M. M. Duncan (employee of owner) or (owner or operator) of the above-described well, being first duly sworn on oath, says: That I have knowledge of the facts, statements, and matters herein contained and the log of the above-described well as filed and that the same are true and correct. So help me God.

(Signature) M. M. Duncan
P. O. Box 1033, Wichita, Kansas
(Address)

SUBSCRIBED AND SWORN TO before me this 5th day of December, 19 54

My commission expires June 23, 1958

Notary Public.

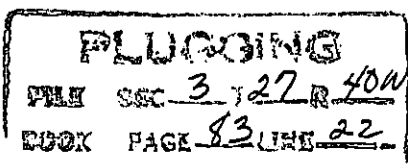

No. 1 JACQUART.

WELL RECORD

Location: C SE/4 Section 3-275-40W,
Stanton County, Kansas

Commenced: November 18, 1954

Operator: William Graham Oil Company
1005 East Second Street
Wichita, Kansas

Completed: December 4, 1954

Elevation: 3194 feet

Contractor: William Graham Oil Company
1005 East Second Street
Wichita, Kansas

Production: Dry

Casing Record: 8 5/8" @ 401' W/275 sacks cement
5 1/2" @ 2312' W/600 sacks cement

LOG

Soil sand and gravel	166
Sand and gravel	265
Shale	430
Sand and shale streaks	485
Red bed	580
Red bed and slate	820
Sand and shale	1050
Red bed and gyp	1255
Red bed W/sand and gyp	1580
Red bed and gyp	1785
Sand	1805
Red bed and anhydrite	2214
Red bed and shale and sand	2315, TD

The undersigned, William Graham Oil Company, hereby certifies that the above log is a true and correct log of the formations encountered in drilling the above well as reflected by the Daily Drilling Report.

WILLIAM GRAHAM OIL COMPANY

Subscribed and sworn to before me this
31st day of December, 1954.

Barbara J. Scott
Notary Public

F. Duncan
F. Duncan

Notary Public
Stanton County, Kansas

DEC 17 1954

DIVISION

501500

My commission expires: December 1, 1956

PLUGGING
FILE SEC 3 T 27 R 40W
BOOK PAGE 83 LINE 22