


STATE OF KANSAS
STATE CORPORATION COMMISSION

Form CP-4

WELL PLUGGING RECORD

Give All Information Completely
Make Required Affidavit
Mail or Deliver Report to:
Conservation Division
State Corporation Commission
211 No. Broadway
Wichita, Kansas

NORTH

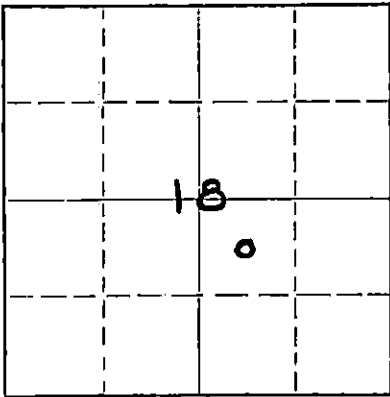

Locate well correctly on above
Section Plat

STANTON County. Sec. 18, Twp. 27S Rge. 40 (E) (W) X

Location as "NE/CNW%SW%" or footage from lines C/NW/4 OF SE/4

Lease Owner DAVIDOR & DAVIDOR, INC.

Lease Name EDNA COLLINGWOOD Well No. 1-18

Office Address 4515 N. SANTA FE, OKLAHOMA CITY, OKLAHOMA 73118

Character of Well (completed as Oil, Gas or Dry Hole) DRY HOLE

Date well completed JANUARY 25, 19 68

Application for plugging filed JANUARY 26 19 68

Application for plugging approved JANUARY 26 19 68

Plugging commenced JANUARY 26 19 68

Plugging completed JANUARY 26 19 68

Reason for abandonment of well or producing formation DRY HOLE

If a producing well is abandoned, date of last production 19

Was permission obtained from the Conservation Division or its agents before plugging was commenced? YES

Name of Conservation Agent who supervised plugging of this well E. EVES, SUBLETTE, KANSAS

Producing formation _____ Depth to top _____ Bottom _____ Total Depth of Well _____ Feet

Show depth and thickness of all water, oil and gas formations.

OIL, GAS OR WATER RECORDS

CASING RECORD

FORMATION	CONTENT	FROM	TO	SIZE	PUT IN	PULLED OUT
				8-5/8"	1729'	NONE

Describe in detail the manner in which the well was plugged, indicating where the mud fluid was placed and the method or methods used in introducing it into the hole. If cement or other plugs were used, state the character of same and depth placed, from _____ feet to _____ feet for each plug set.

HOLE WAS FULL OF MUD.

SET 35 SACK CEMENT PLUG AT 900 FEET (BOTTOM OF PLUG)

SET 15 SACK CEMENT PLUG FROM 40 FEET TO SURFACE.

RECEIVED
STATE CORPORATION COMMISSION

FEB 1 - 1968

CONSERVATION DIVISION
Wichita, Kansas

(If additional description is necessary, use BACK of this sheet)

Name of Plugging Contractor SUN OIL WELL CEMENTING, INC. AND MURFIN DRILLING COMPANY

Address SUN - LIBERAL, KANSAS MURFIN - WICHITA, KANSAS

STATE OF OKLAHOMA, COUNTY OF OKLAHOMA, ss.

HAROLD DAVIDOR (employee of owner) or (owner or operator) of the above-described

well, being first duly sworn on oath, says: That I have knowledge of the facts, statements, and matters herein contained and the log of the above-described well as filed and that the same are true and correct. So help me God.

(Signature)

Harold Davidor


4515 N. SANTA FE, OKLAHOMA CITY, OKLAHOMA 73118
(Address)

SUBSCRIBED AND SWORN to before me this 31st day of JANUARY, 19 68

m. m. Griffin

Notary Public.

MARCH 23, 1970

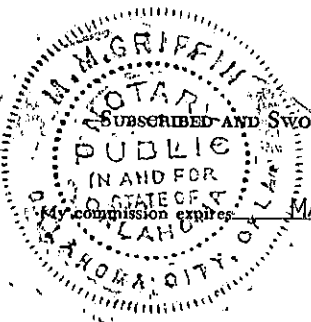

WELL LOG

COMPANY Davidor & Davidor

SEC. 18 T. 27s R. 40W
LOC. NW SE

FARM COLLINGWOOD NO. #1-18

RIG. NO. 8

TOTAL DEPTH 5510'

COUNTRY Stanton - Kansas
KANSAS


COMM. 1-10-68

COMP. 1-27-68

SHOT OR TREATED

CONTRACTOR MURFIN DRILLING COMPANY

ISSUED

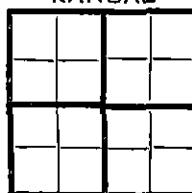

CASINO

20 10
15 8 5/8" @ 1729' w/750 SX
12 6
13 5

ELEVATION

PRODUCTION D&A

FIGURES INDICATE BOTTOM OF FORMATIONS


325	Sand
510	Shale
1295	Shale & Sand - Red Bed - Gyp
1565	Red Bed & Shells
1718	Shale - Shells
1730	Anhydrite
2120	Shale - Shells
2197	Red Bed
2402	Shale
2440	Lime - Shale
2570	Shale
2670	Shale - Lime
2755	Lime & Shale
2885	Shale - Lime
2968	Lime - Shale
3125	Lime
3385	Lime - Shale
3560	Lime
3690	Lime - Shale
3900	Lime
4023	Shale - Lime
4140	Lime - Shale
4255	Lime
4430	Lime - Chalky
4505	Lime
5010	Lime & Shale
5240	Shale & Lime
5505	Lime

RECEIVED
STATE CORPORATION COMMISSION
FEB 29 1968
CONSERVATION DIVISION
Wichita, Kansas

State of KANSAS }
County of SEDGWICK } ss:

I, James R. Daniels of the MURFIN DRILLING Company

upon oath state that the above and foregoing is a true and correct copy of the log of the COLLINGWOOD #1-18 well.

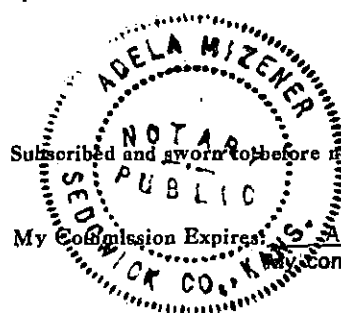

James R. Daniels
James R. Daniels
February 19 68

Subscribed and sworn to before me this 29th day of _____
My Commission Expires November 5, 1970
ADELA MIZENER, Notary Public
My commission expires November 5, 1970

Adela Mizener
NOTARY PUBLIC