


STATE OF KANSAS
STATE CORPORATION COMMISSION

WELL PLUGGING RECORD

Give All Information Completely
Make Required Affidavit
Mail or Deliver Report to
Conservation Division
State Corporation Comm.
245 North Water
Wichita, KS 67202

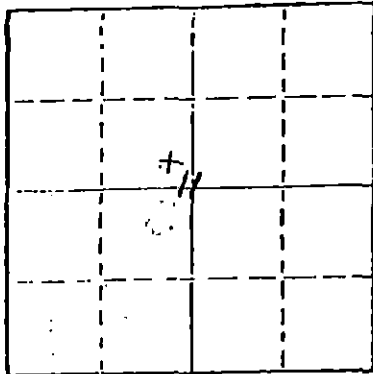

Locate well correctly on above
Section Plat

Stanton County. Sec. 11 Twp. 27S Rge. 41 ^{SW}/₄
Location as "NE/CNW¹/₄SW¹/₄" or footage from lines
2540 Ft. FNL & 2440 FT. FWL
Lease Owner Amoco Production Company
Lease Name James W. Raney Well No. 1
Office Address P. O. Box 432, Liberal, Kansas 67901
Character of Well (Completed as Oil, Gas or Dry Hole) Dry Hole
Date Well completed 8-1 1978
Application for plugging filed 6-28 1978
Application for plugging approved 7-3 1978
Plugging commenced 8-2 1978
Plugging completed 8-3 1978
Reason for abandonment of well or producing formation Dry Hole
If a producing well is abandoned, date of last production 19

Was permission obtained from the Conservation Division or its agents before plugging was commenced? Yes

Name of Conservation Agent who supervised plugging of this well Clarence Thomas
Producing formation _____ Depth to top _____ Bottom _____ Total Depth of Well 2992
Show depth and thickness of all water, oil and gas formations.

OIL, GAS OR WATER RECORDS

CASING RECORD

| FORMATION | CONTENT | FROM | TO | SIZE | PUT IN | PULLED OUT |
|---------------|---------|------|------|-------|--------|------------|
| Chase | | 2231 | 2396 | 8 5/8 | 632 | None |
| FT. Riley | | 2396 | 2490 | 5 1/2 | 2992 | None |
| Council Grove | | 2490 | 2992 | | | |

Describe in detail the manner in which the well was plugged, indicating where the mud fluid was placed and the method or methods used in introducing it into the hold. If cement or other plugs were used, state the character of same and depth placed, from _____ feet to _____ feet for each plug set. Pump 375 sacks cement into hole. Fill from 2992 FT. to 2350 FT. Shut down for 24 hr, pump additional 75 sacks cement to 6 FT. Below surface. Cut off casing 3 FT. Below surface weld on cap. Plugged & abandoned 0100 hr. 8-3-78.

RECEIVED
STATE CORPORATION COMMISSION

AUG 16 1978 8-16-78

CONSERVATION DIVISION
Wichita, Kansas

(If additional description is necessary, use BACK of this sheet)

Name of Plugging Contractor _____

STATE OF Kansas COUNTY OF Seward, ss.
Gale McCord (employee of owner) or (owner or operator)
of the above-described well, being first duly sworn on oath, says: That I have knowledge of the facts, statements, and matters herein contained and the log of the above-described well as filed and that the same are true and correct. So help me God.

(Signature) Gale McCord Gale McCord
P. O. Box 432, Liberal, KS Admin. Supvr.
(Address) 67901

SUBSCRIBED AND SWORN TO before me this 8 day of August, 19 78

J. L. Dressen J. L. Dressen
Notary Public.

My commission expires 2-2-81

