


STATE OF KANSAS
STATE CORPORATION COMMISSION

WELL PLUGGING RECORD

Give All Information Completely
Make Required Affidavit
Mail or Deliver Report to:
Conservation Division
State Corporation Commission
800 Biting Building
Wichita, Kansas

Stanton m County. Sec. 24 Twp. 27S Rge. 41 (W)
Location as "NE/CNW $\frac{1}{4}$ SW $\frac{1}{4}$ " or footage from lines 150' South & East of Center
Lease Owner United Producing Co., Inc.
Lease Name M.G. Raney Well No. 1
Office Address Box 127, Satanta, Kansas
Character of Well (completed as Oil, Gas or Dry Hole) Dry Hole
Date well completed May 12, 1951 19
Application for plugging filed May 11, 1951 - Verbal - See Below 19
Application for plugging approved October 4, 1951 19
Plugging commenced May 12, 1951 19
Plugging completed Plug Not Completed - See Below 19
Reason for abandonment of well or producing formation Dry Hole
If a producing well is abandoned, date of last production None 19
Was permission obtained from the Conservation Division or its agents before plugging was commenced? Yes

NORTH

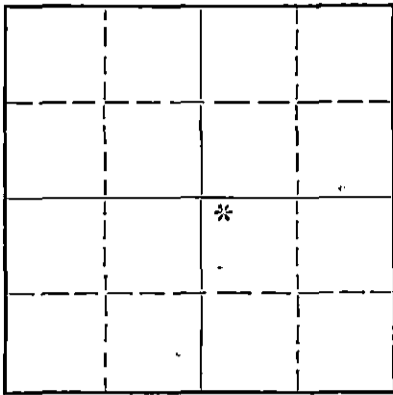

Locate well correctly on above Section Plat

Name of Conservation Agent who supervised plugging of this well R. J. Phillippe
Producing formation Hugoton Series Depth to top 2221 Bottom 2423 GL. Total Depth of Well 2435 GL Feet
Show depth and thickness of all water, oil and gas formations.

OIL, GAS OR WATER RECORDS

CASING RECORD

Formation	sand / Content	From	To	Size	Put In	Pulled Out
Surface Soil & Fresh Water	Fresh Water	185	235	10 3/4" OD	393	None
Chase Series - Salt Water	Salt Water & Salt Mass	235	2221	7" OD	2224	None
All Of Hugoton Series	Barren & Salt Water	2221	2423	Open Hole		

Describe in detail the manner in which the well was plugged, indicating where the mud fluid was placed and the method or methods used in introducing it into the hole. If cement or other plugs were used, state the character of same and depth placed, from _____ feet to _____ feet for each plug set.

2435 to 2000 - Cement
2000 to Surface - Fresh Water
2284 to 2278 - Lime Chat
2278 to 2277 - Oakum
2277 to 2275 - Lead Wool
2275 to 2274 - Oakum
2274 to 2270 - Lead Wool
2270 to 2269 - Oakum
2269 to 2267 - Lead Wool
2267 to 2266 - Oakum
2266 to 2260 - Lead Wool
2260 to 2254 - Chat
2254 to 2100 - Cement - Top Of Plug - 98 feet cement in 7" OD casing.

Temporarily Abandoned - If permanently abandoned, remainder of hole will be plugged in accordance with state requirements and another report made.

(If additional description is necessary, use BACK of this sheet)

Correspondence regarding this well should be addressed to Arthur H. Robinson - Dist. Supt. - United Producing Co., Inc. - Box 127, Satanta, Kansas

STATE OF Kansas, COUNTY OF Haskell, ss.
Arthur H. Robinson (employee of owner) or (owner or operator) of the above-described well, being first duly sworn on oath, says: That I have knowledge of the facts, statements, and matters herein contained and the log of the above-described well as filed and that the same are true and correct. So help me God

(Signature) *Arthur H. Robinson*
Satanta, Kansas (Address)

SUBSCRIBED AND SWORN to before me this 12 day of October, 19 51
William B. Claunch
Notary Public.

My commission expires August 30, 1952

23-5091-s 8-50-10M

PLUGGING
FILE SEC 24 T 27 R 41 W
BOOK PAGE 114 LINE 5

OCT 30 1951
CONSERVATION DIVISION
WICHITA, KANSAS
10-30-51

LOG OF WELL - UNITED PRODUCING CO., INC.
M. RANEY No. 1

ROTARY

FROM	TO	FORMATION
00	40	Sand & Gravel
40	185	Sand & Clay
185	235	Sand & Gravel
235	330	Sand & Clay
330	364	Blue Shale
364	426	Blue Shale, sand break
426	620	Blue Shale
620	840	Blue Shale, Gyp, Red Shale
840	1036	Red Bed & Shale
1036	1299	Red Bed, shale & anhydrite
1299	1624	Shale, gyp & anhydrite
1624	1735	Lime & Shale
1735	1948	Shale, Red bed & Anhydrite
1948	2055	Shale, Anhydrite & Lime
2055	2247	Anhydrite, shale
2247	2268	Anhydrite shale
2268	2440	Shale Lime

Set & cemented 10 3/4" OD Casing @ 392 Ft. 250 Sx.
Cemented Bottom of Hole 2440 Ft. 60 Sx.
Set & Cemented 7" OD Casing @ 2224 100 Sx.

Began drilling April 18, 1951

CABLE TOOLS

Bailing, drilling, swabbing, etc. - 2224 to 2287

Testing, acidizing, bailing, etc.

Ran 150 Sacks cement to bottom and loading hole with water.

Orig: State Corp. Comm.
CC: R. V. Sleeth
Liberal Office
Well file

DEC 12 1953
CORRELATION DIVISION
Wichita, Kansas

PLUGGING
FILE SEC 24 T 27 R 41W
BOOK PAGE 114 LINE 5