


STATE OF KANSAS
STATE CORPORATION COMMISSION

WELL PLUGGING RECORD

Give All Information Completely
Make Required Affidavit
Mail or Deliver Report to:
Conservation Division
State Corporation Commission
212 North Market, Insurance Bldg.
Wichita, Kansas

Stanton County, Sec. 28 Twp. 27 Rge. 43 (X) (W)
Location as "NE/CNW/SW" or footage from lines C NE NE
Lease Owner Five Nation Drilling Co., Inc.
Lease Name Collingwood Well No. 1
Office Address 519 Beacon Building, Wichita 2, Kansas
Character of Well (completed as Oil, Gas or Dry Hole) Dry Hole
Date well completed May 1, 1960 19 60
Application for plugging filed May 2 19 60
Application for plugging approved May 2 19 60
Plugging commenced May 2 19 60
Plugging completed May 2 19 60
Reason for abandonment of well or producing formation Dry Hole

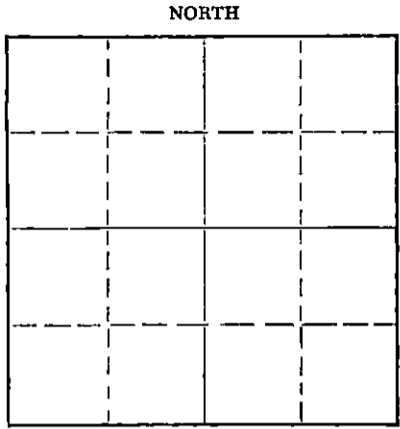

Locate well correctly on above
Section Plat

If a producing well is abandoned, date of last production _____ 19 ____
Was permission obtained from the Conservation Division or its agents before plugging was commenced? yes

Name of Conservation Agent who supervised plugging of this well Frank Broadfoot
Producing formation none Depth to top _____ Bottom _____ Total Depth of Well _____ Feet
Show depth and thickness of all water, oil and gas formations.

OIL, GAS OR WATER RECORDS

CASING RECORD

FORMATION	CONTENT	FROM	TO	SIZE	PUT IN	PULLED OUT
				8 5/8	1677	none

Describe in detail the manner in which the well was plugged, indicating where the mud fluid was placed and the method or methods used in introducing it into the hole. If cement or other plugs were used, state the character of same and depth placed, from _____ feet to _____ feet for each plug set.

100 sacks cement 2500 to 2800
25 sacks " at 1650
25 sacks " at 500
25 sacks " at 40

RECEIVED
STATE CORPORATION COMMISSION

MAY 13 1960

CONSERVATION DIVISION
Wichita, Kansas

(If additional description is necessary, use BACK of this sheet)
Name of Plugging Contractor Frank Broadfoot
Address Box 192, St. John, Kansas

STATE OF Kansas, COUNTY OF Sedgwick, ss.
H. J. Groves (employee of owner) or (owner or operator) of the above-described well, being first duly sworn on oath, says: That I have knowledge of the facts, statements, and matters herein contained and the log of the above-described well as filed and that the same are true and correct. So help me God.

(Signature) H. J. Groves
519 Beacon Building, Wichita 2, Kansas
(Address)

SUBSCRIBED AND SWORN TO before me this 2nd day of May, 19 60
Carol Virginia Christ
Notary Public.

My commission expires 9/9/62



KANSAS GEOLOGICAL SOCIETY
 KANSAS WELL LOG BUREAU - KANSAS WELL SAMPLE BUREAU
 KANSAS GEOLOGICAL SOCIETY BUILDING
 508 EAST MURDOCK - WICHITA, KANSAS

COMPANY **Five Nation Drilling Co., Inc.**

SEC. 28 T. 27 R. 43W
 LOC. C NENE

FARM **Collingwood** NO. 1

TOTAL DEPTH **5660'**

COUNTY **Stanton**


COMM. **4-5-60**

COMP. **5-1-60**

SHOT OR TREATED

CONTRACTOR **Cherokee Drilling & Exploration Co.**

ISSUED

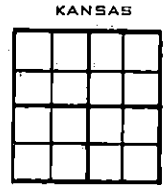

CASING

20	10
15	B - 1677'
12	6
13	5

ELEVATION **3557 K & B**

PRODUCTION **D & A**

FIGURES INDICATE BOTTOM OF FORMATIONS

15-180	Sd
495	Sh & Ls
750	Sd & Sh
815	Ls & Sh
975	Sh w/Ls Stks
1155	Shly Ls
1318	Ls & Sh
1375	Ls
1668	Sd & Sh
1674	Ls
1685	Ls & Sh
1765	Red Bed
1780	Red Bed & Ls
2125	Sh & Sd
2405	Sh & Red Bed
2465	Sh & Ls
2685	Sh & Ls
2700	Sh
2790	Ls & Sh Stks
2845	Ls
2910	Ls & Sh
3140	Sh
3280	Sh & Ls
3340	Sh w/Ls Stks
3430	Sh w/Ls Stks
3477	Ls & Sh
3637	Ls
3725	Ls & Sh
3893	Ls
4563	Ls
4805	Sh & Ls
4870	Sh & Ls Stks
5032	Sh & Ls
5206	Ls
5535	Sh & Ls
5660	Ls
	TD

RECEIVED
 STATE CORPORATION COMMISSION

MAY 13 1960

CON. DIVISION
 WICHITA, KANSAS