


STATE OF KANSAS
STATE CORPORATION COMMISSION

Give All Information Completely
Make Required Affidavit
Mail or Deliver Report to:
Conservation Division
State Corporation Commission
211 No. Broadway
Wichita, Kansas

WELL PLUGGING RECORD

NORTH

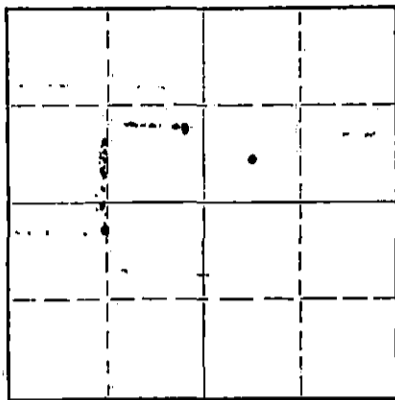

Locate well correctly on above
Section Plot

Stanton County. Sec. 28 Twp. 27S Rge. (E) 43 (W)

Location as "NE/CNW*SW*" or footage from lines C SW NE
Lease Owner Cities Service Petroleum Company
Lease Name Collingwood "B" Well No. 1
Office Address Box 1098 Liberal, Kansas
Character of Well (completed as Oil, Gas or Dry Hole) Dry hole
Date well completed August 1, 1962
Application for plugging filed 19
Application for plugging approved 19
Plugging commenced August 2, 1962
Plugging completed August 2, 1962
Reason for abandonment of well or producing formation Dry hole

If a producing well is abandoned, date of last production 19
Was permission obtained from the Conservation Division or its agents before plugging was commenced? Yes

Name of Conservation Agent who supervised plugging of this well Mr. Hugh Scott
Producing formation Depth to top Bottom Total Depth of Well 4420 Feet
Show depth and thickness of all water, oil and gas formations.

OIL, GAS OR WATER RECORDS

CASING RECORD

FORMATION	CONTENT	FROM	TO	SIZE	PUT IN	PULLED OUT
Lansing	630' saltwater	3961	4000	8-5/8	1669	None
Lansing	1380' "	4102	4150			
Marmaton	540' "	4374	4420			

Describe in detail the manner in which the well was plugged, indicating where the mud fluid was placed and the method or methods used in introducing it into the hole. If cement or other plugs were used, state the character of same and depth placed, from feet to feet for each plug set.

Spotted 20 sx cement thru drill pipe from 4420' to 4355'
Spotted heavy mud thru drill pipe from 4355' to 4170'
Spotted 25 sx cement thru drill pipe from 4170' to 4090'
Spotted heavy mud thru drill pipe from 4090' to 4010'
Spotted 25 sx cement thru drill pipe from 4010' to 3930'
Spotted heavy mud thru drill pipe from 3930' to 1700'
Spotted 30 sx cement thru drill pipe from 1700' to 1620'
Spotted heavy mud thru drill pipe from 1620' to 30'
Spotted 10 sx cement thru drill pipe from 30' to surface

RECEIVED
STATE CORPORATION COMMISSION

AUG 13 1962

CONSERVATION DIVISION
Wichita, Kansas

8-13-62

(If additional description is necessary, use BACK of this sheet)

Name of Plugging Contractor Sun Oil Cementing Company
Address Hays, Kansas

STATE OF Kansas, COUNTY OF Seward, ss.
W. J. Devaney (employee of owner) or (owner) of the above-described well, being first duly sworn on oath, says: That I have knowledge of the facts, statements, and matters herein contained and the log of the above-described well as filed and that the same are true and correct. So help me God.

(Signature) W. J. Devaney
Box 1098 Liberal, Kansas
(Address)


SUBSCRIBED AND SWORN TO before me this 6th day of August, 1962

My commission expires 5-23-65

J. T. Mabrey Notary Public

(Main Office: Oklahoma Commission, Oklahoma City, Oklahoma)
OKLAHOMA CORPORATION COMMISSION
 OIL AND GAS CONSERVATION DEPARTMENT

640 Acres
 N

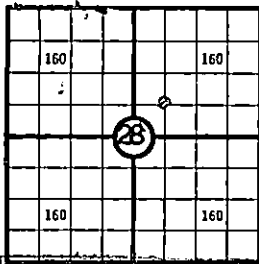

WELL RECORD

COUNTY Stanton SEC. 28 TWP. 27S RGE. 43W
 COMPANY OPERATING Cities Service Petroleum Co
 OFFICE ADDRESS Box 1098 Liberal, Kansas
 FARM NAME Collingwood "B" WELL NO. 1
 DRILLING STARTED 7-12-1962 DRILLING FINISHED 8-1-1962
 DATE OF FIRST PRODUCTION _____ COMPLETED _____
 WELL LOCATED C $\frac{1}{4}$ SW $\frac{1}{4}$ NE _____ North of South
 Line and _____ ft. East of West Line of Quarter Section
 Elevation (Relative to sea level) DERRICK FLOOR 3603 GROUND 3597

Indicate well correctly

CHARACTER OF WELL (Oil, gas or dryhole)

OIL OR GAS SANDS OR ZONES

Name	From	To	Name	From	To

FORMATION RECORD

Give detailed description and thickness of all formations drilled through, starting at sand whether dry, water, oil or gas.

Formation	Top	Bottom	Formation	Top	Bottom
Surface clay & sand	0	150			
Sand	150	585			
Sand, red bed & anhydrite	585	929			
Red bed, gyp & sand	929	1155			
Red bed & anhydrite	1155	1294			
Sand & gypsum	1294	1650			
Sand	1650	1665			
Anhydrite	1665	1670			
Limestone	1670	1718			
Shale	1718	1730			
Anhydrite & shale	1730	1960			
Shale & sandy lime	1960	2175			
Shale & lime	2175	2495			
Lime & shale	2495	2690			
Lime	2690	2963			
Lime & shale	2963	3163			
Lime	3163	3275			
Lime & shale	3275	3510			
Shale	3510	3513			
Limestone	3513	4420			
T.D.	4420				

RECEIVED
 STATE CORPORATION COMMISSION
 AUG 13 1962
 CONSERVATION DIVISION
 Wichita, Kansas