

STATE OF KANSAS
STATE CORPORATION COMMISSION
200 Colorado Derby Building
Wichita, Kansas 67202

WELL PLUGGING RECORD
K.A.R.-82-3-117

API NUMBER _____

LEASE NAME Baughman G.U. D

WELL NUMBER #1

2740' Ft. from S Section Line

2540' Ft. from E Section Line

SEC. 33 TWP. 27 RGE. 39 XX or (W)

COUNTY Stanton

Date Well Completed _____

Plugging Commenced 10-21-1991

Plugging Completed 10-25-1991

TYPE OR PRINT
NOTICE: Fill out completely
and return to Cons. Div.
office within 30 days.

LEASE OPERATOR Amoco Production Co.

ADDRESS P.O. Box 800, Denver, CO 80201

PHONE# (303) 830-4009 OPERATORS LICENSE NO. 5952

Character of Well Gas

(Oil, Gas, D&A, SWD, Input, Water Supply Well)

The plugging proposal was approved on 10-18-91 (date)

by Steve Middleton (KCC District Agent's Name).

Is ACO-1 filed? yes If not, is well log attached? _____

Producing Formation Chase Depth to Top 2293' Bottom 2500' T.D. 2500'

Show depth and thickness of all water, oil and gas formations.

OIL, GAS OR WATER RECORDS | CASING RECORD

Formation	Content	From	To	Size	Put in	Pulled out
Surface				10 3/4"	676'	0'
Production				7"	2293'	0'
Liner				5 1/2"	236'	0'

10-30-91
RECEIVED
STATE CORPORATION COMMISSION

Describe in detail the manner in which the well was plugged, indicating where the mud fluid was placed and the method or methods used in introducing it into the hole. If cement or other plugs were used, state the character of same and depth placed, from ___ feet to ___ feet each set.

Sand to 1930' - Set CIBP @ 1920' - capped w/3 Sks Cement
Mud to 660' - Pump 250 Sks. cement 660' to 5'
Cut off 10 3/4" & 7", 5' below ground level and cap.

Witnessed by Mr. Glen Barlow w/K.C.C.
(If additional description is necessary, use BACK of this form.)

Name of Plugging Contractor MIDWEST CASING PULLING SERVICE License No. 6497

Address Box F, Sublette, Ks 67877

NAME OF PARTY RESPONSIBLE FOR PLUGGING FEES: Amoco Production Co.

STATE OF KANSAS COUNTY OF HASKELL, ss.

I, Edgar J. Eves (Employee of Operator) or Operator of above-described well, being first duly sworn on oath, says: That I have knowledge of the facts, statements, and matters herein contained and the log of the above-described well as filed that the same are true and correct, so help me God.



(Signature) Edgar J. Eves

(Address) Box F, Sublette, Ks. 67877

SUBSCRIBED AND SWORN TO before me this 28th day of Oct., 1991


Sondral Eves
Notary Public

My Commission Expires: 12-12-92

A

1

BAUGHMAN GAS UNIT "D" #1
SECTION 33-27S-39W
PLUGGING AND ABANDONMENT

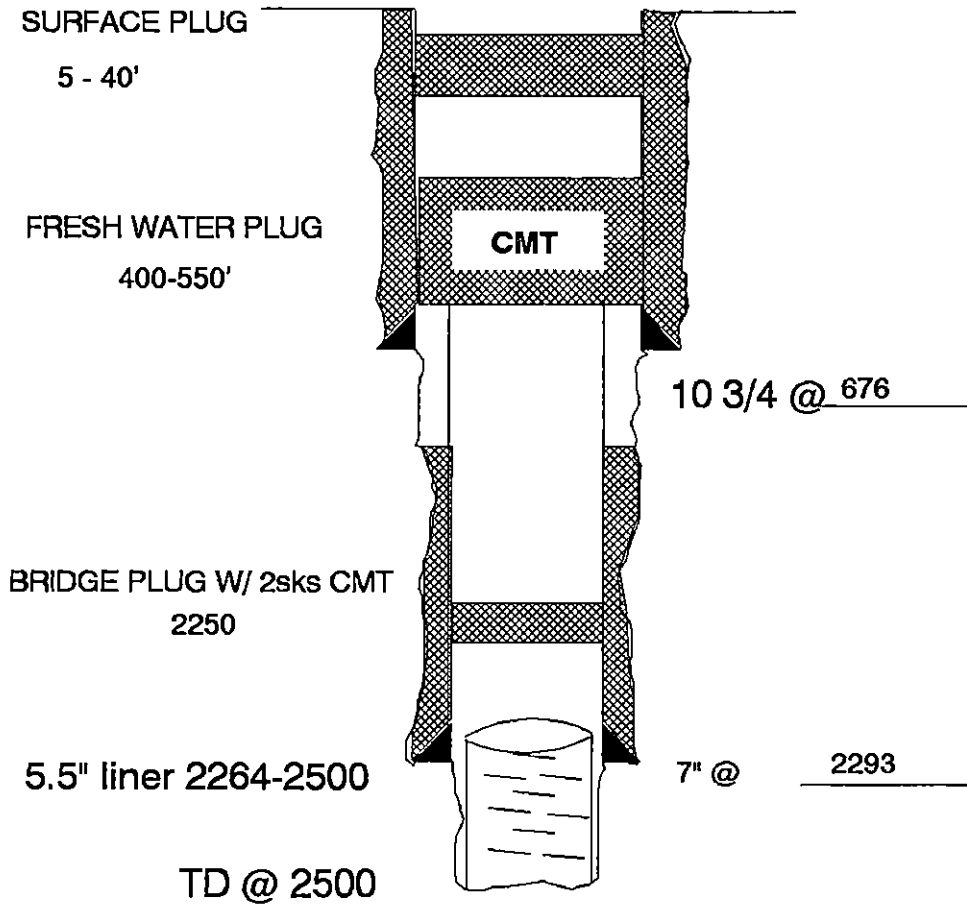

RECEIVED
KANSAS CORPORATION COMMISSION

OCT 1 1991

CONSERVATION DIVISION
WICHITA, KS