


STATE OF KANSAS
STATE CORPORATION COMMISSION
CONSERVATION DIVISION
P. O. BOX 17027
WICHITA, KANSAS 67217

WELL PLUGGING RECORD

Haskell County, Sec 15, Twp 27, Rge. (E) 32 (W) 1/4
Location as "NE/CNW/SW" or footage from lines 70' N & 70' W of Center of NW 1/4
Lease Owner JACK C. WALLACE
Lease Name Brock & Kelly Well No. 1
Office Address 50 Penn Place, Suite 600, Okla City, Oklahoma 73118
Character of Well (completed as Oil, Gas or Dry Hole) dry hole
Date well completed 1979
Application for plugging filed 1-10 (Verbal Permission was given 1979)
Application for plugging approved 1-10 1979
Plugging commenced 12-7 1978
Plugging completed 12-7 1978
Reason for abandonment of well or producing formation LOST HOLE

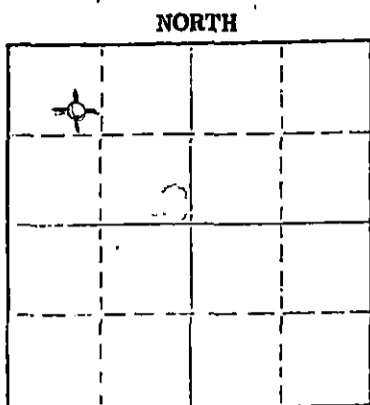

Locate well correctly on above Section Plat

If a producing well is abandoned, date of last production 1979
Was permission obtained from the Conservation Division or its agents before plugging was commenced? Yes

Name of Conservation Agent who supervised plugging of this well Clarence Thomas
Producing formation _____ Depth to top _____ Bottom _____ Total Depth of Well _____ Feet
Show depth and thickness of all water, oil and gas formations.

OIL, GAS OR WATER RECORDS

CASING RECORD

FORMATION	CONTENT	FROM	TO	SIZE	PUT IN	PULLED OUT

Describe in detail the manner in which the well was plugged, indicating where the mud fluid was placed and the method or methods used in introducing it into the hole. If cement or other plugs were used, state the character of same and depth placed, from 770' feet to 40' feet for each plug set.

Drill pipe was lowered to the depth of 770' and 40 sacks of cement were pumped @ that depth using 12# mud to displace with. Brought drill pipe up to 40' and 20 sacks of cement were pumped @ that depth using 12# mud to displace with. Then 5 sacks of cement were pumped into the rat hole using 12 # mud to displace with.

RECEIVED
STATE CORPORATION COMMISSION
JAN 19 1979
CONSERVATION DIVISION
Wichita, Kansas

Name of Plugging Contractor DOWELL
Address Ulysses, Kansas

STATE OF OKLAHOMA COUNTY OF OKLAHOMA ss.

(employee of owner) or (owner or operator) of the above-described well, being first duly sworn on oath, says: That I have knowledge of the facts, statements, and matters herein contained and the log of the above-described well as filed and that the same are true and correct. So help me God.

(Signature) [Handwritten Signature]

Subscribed and Sworn to before me this 15th day of January 1979

My commission expires 12-22-80 (Address) Dan F. Wallace Notary Public.