


STATE OF KANSAS
STATE CORPORATION COMMISSION

Form CP-4

Give All Information Completely
Make Required Affidavit
Mail or Deliver Report to:
Conservation Division
State Corporation Commission
212 No. Market
Wichita, Kansas 67202

WELL PLUGGING RECORD

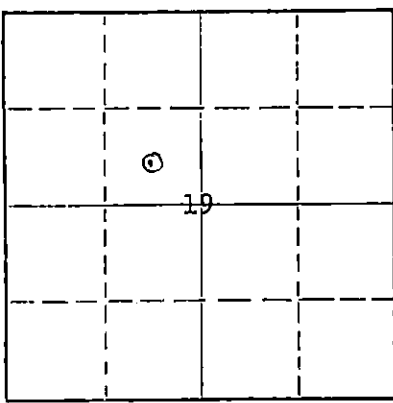

Locate well correctly on above
Section Plat

Haskell County, Sec. 19 Twp 27S Rge. (E) 33 (W)
Location as "NE/CNW/SW" or footage from lines SE/4, NW/4
Lease Owner Cities Service Oil Company
Lease Name Frey "C" Well No. 1
Office Address Box 1098, Liberal, Kansas 67901
Character of Well (completed as Oil, Gas or Dry Hole) Gas
Date well completed 8-8 19 49
Application for plugging filed March 2 19 70
Application for plugging approved March 3 19 70
Plugging commenced April 11 19 70
Plugging completed April 12 19 70
Reason for abandonment of well or producing formation Excess Water

If a producing well is abandoned, date of last production April 2 19 70
Was permission obtained from the Conservation Division or its agents before plugging was commenced? Yes

Name of Conservation Agent who supervised plugging of this well E. Eves
Producing formation Hugoton Depth to top 2627' Bottom 2720' Total Depth of Well 2727 Feet
Show depth and thickness of all water, oil and gas formations.

OIL, GAS OR WATER RECORDS CASING RECORD

FORMATION	CONTENT	FROM	TO	SIZE	PUT IN	PULLED OUT
Krider	Gas & Water	2627'	2675'	10-3/4"	600'	0
Winfield	" "	2695'	2720'	7"	2627'	0
				5 1/2" liner	2596' to	
					2727'	0

Describe in detail the manner in which the well was plugged, indicating where the mud fluid was placed and the method or methods used in introducing it into the hole. If cement or other plugs were used, state the character of same and depth placed, from _____ feet to _____ feet for each plug set.

- 100 sx cement 2520' - 2727'
- Halliburton SVEZ squeeze packer 2520'
- 100 sx cement 2120' - 2520'
- Heavy mud 600' - 2120'
- 30 sx cement 480' - 600'
- Heavy mud 40' - 480'
- 15 sx cement 0' - 40'
- P & A

RECEIVED
STATE CORPORATION COMMISSION
APR 14 1970
CONSERVATION DIVISION
Wichita, Kansas

(If additional description is necessary, use BACK of this sheet)
Name of Plugging Contractor Cities Service Oil Company
Address Box 1098, Liberal, Kansas 67901

STATE OF KANSAS, COUNTY OF SEWARD, ss.
R. L. Higginbottom (employee of owner) or (owner or operator) of the above-described well, being first duly sworn on oath, says: That I have knowledge of the facts, statements, and matters herein contained and the log of the above-described well as filed and that the same are true and correct. So help me God.

(Signature) [Signature]
Box 1098, Liberal, Kansas 67901 (Address)

SUBSCRIBED AND SWORN TO before me this 13th day of April 19 70

My commission expires 5-23-73 J. T. Mabrey Notary Public.

COLUMBIAN FUEL CORPORATION

GEORGE FREY: #0-1

LOCATION: SE/4 of NW/4 of Section 19, TWP. 27S, RGS. 33W, Haskell County, Kansas

DATE COMMENCED: 7-24-49

DATE COMPLETED: 8-8-49

ELEVATION: 2973'

TOTAL DEPTH: 2,773'

OPEN FLOW CAPACITY: 6,838 M.C.F.

ROCK PRESSURE: 407'

RECEIVED
STATE CORPORATION COMMISSION
MAR 3 1970
CONSERVATION DIVISION
Wichita, Kansas

ROTARY TOOLS

<u>TOP</u>	<u>BOTTOM</u>	<u>FORMATION</u>
0	400'	Clay & Sand
400'	510'	Clay
510'	615'	Sandy Clay
615'	862'	Clay & Red Bed
862'	968'	Red Bed & Gyp. & Shale
968'	1,125'	Shale & Lyp.
1,125'	1,288'	Shale
1,288'	1,450'	Shale & Shell
1,450'	1,715'	Shale & Salt
1,715'	1,926'	Shale
1,926'	1,936'	Anhydrite
1,936'	1,986'	Salt & Shale
1,986'	2,004'	Shale
2,004'	2,085'	Shale & Shells
2,085'	2,140'	Shale
2,140'	2,330'	Shell & Shale
2,330'	2,544'	Anhydrite & Shale
2,544'	2,617'	Lime & Shale
2,617'	2,635'	Lime

CABLE TOOLS

2,635'	2,679'	Lime
2,679'	2,697'	Red & Blue Shale
2,697'	2,724'	Lime
2,724'	2,748'	Red & Blue Shale
2,748'	2,773'	Lime

CASING RECORD

- 10" - Casing Left in Hole - 600'
- 7" - Casing Left in Hole - 2,627'
- 5" - Casing Left in Hole - 183'

GAS PAYS

2,620' - 2,661'

LOG OF LINER

- Blank from 2,620' to 2,627'
- Perforated from 2,627' to 2,675' - 48
- Blank from 2,675' to 2,695'
- Perforated from 2,695' to 2,720' 25
- Blank from 2,720' to 2,735'
- Perforated from 2,735' to 2,773' 40

This liner was set at 2,620' and run with a J Tool Shoe.