


STATE OF KANSAS  
STATE CORPORATION COMMISSION

Give All Information Completely  
Make Required Affidavit  
Mail or Deliver Report to:  
Conservation Division  
State Corporation Commission  
800 Bitting Building  
Wichita, Kansas

WELL PLUGGING RECORD

Haskell County, Sec. 8 Twp. 27 Rge. 31 (E) (W)  
Location as "NE/CNW 1/4 SW 1/4" or footage from lines 150' W. & 150' N. of Center  
Lease Owner Wm. Graham Oil Company  
Lease Name Hoffman Well No. 1  
Office Address 1005 E. Second, Wichita, Kansas  
Character of Well (completed as Oil, Gas or Dry Hole) Dry Hole  
Date well completed December 1 1954  
Application for plugging filed December 2 19 54  
Application for plugging approved December 2 19 54  
Plugging commenced December 2 19 54  
Plugging completed December 2 19 54  
Reason for abandonment of well or producing formation No gas, salt wtr.

NORTH

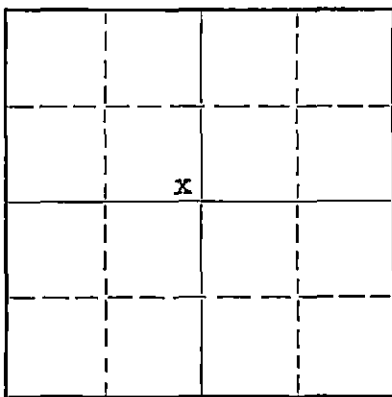

Locate well correctly on above  
Section Plat

Name of Conservation Agent who supervised plugging of this well Gordon D. Farr, Lakin, Ks.  
Producing formation Hugoton Depth to top 2688 Bottom 2712 Total Depth of Well 2729 Feet  
Show depth and thickness of all water, oil and gas formations.

OIL, GAS OR WATER RECORDS

CASING RECORD

Formation	Content	From	To	Size	Put In	Pulled Out
Herington-Krider	x	2678	2720	8 5/8"	515'	None
				5 1/2"	2729'	None

Describe in detail the manner in which the well was plugged, indicating where the mud fluid was placed and the method or methods used in introducing it into the hole. If cement or other plugs were used, state the character of same and depth placed, from \_\_\_\_\_ feet to \_\_\_\_\_ feet for each plug set.

All formations squeezed off with 250 sacks, cement.  
Cement from bottom to 1400'.  
Drilling mud from 1400' to 25'.  
Cement from 25' to 6' below ground level. Cap welded over 5 1/2".  
Cellar filled.

(If additional description is necessary, use BACK of this sheet)

Correspondence regarding this well should be addressed to Wm. Graham Oil Company  
Address 1005 E. Second, Wichita, Kansas

STATE OF Kansas, COUNTY OF Finney, ss.

Ralph Hinkle (employee of owner) or (owner or operator) of the above-described well, being first duly sworn on oath, says: That I have knowledge of the facts, statements, and matters herein contained and the log of the above-described well as filed and that the same are true and correct. So help me God.

(Signature) Ralph Hinkle  
Box 455 Garden City, Ks.  
(Address)

SUBSCRIBED AND SWORN to before me this 3rd day of December, 1954

My commission expires June 13, 1958

Jess C. Munn  
Notary Public.

23-5091-s 8-50-10M

PLUGGING  
WELL SEC 8 T 27 R 31 W  
BOOK PAGE 82 LINE 10

12-6-54

Hoffman  
NO. 1 ~~HOSKINSON~~

WELL RECORD

Location: 150' N & 150' W of center of Section 8-27S-31W, Haskell County, Kansas  
Commenced: Nov. 12, 1954  
Completed: December 2, 1954  
Operator: William Graham Oil Company  
1005 East Second Street  
Wichita, Kansas  
Elevation: 2830' D.F.  
Prod. Dry  
Contractor: William Graham Oil Company  
1005 East Second Street  
Wichita, Kansas  
Casing Record: 8 5/8" @ 514' W/300 sacks cement  
5 1/2" @ 2729' W/ 600 sacks cement

LOG

Gravel and blue clay	515
Shale W/sd streaks	740
Red bed W/shale	1075
Shale anhydrite W/salt & red bed	1205
Shale & red bed	1330
Red bed and sand	1600
Sandy red bed and gyp	1833
Red bed and gyp	1880
Anhydrite	2000
Anhydrite W/red bed	2165
Red bed and shale	2290
Red bed & streaks anhydrite	2470
Anhydrite W/red bed streaks	2553
Anhydrite & red bed	2720
Shale	2730, RTD

The undersigned, William Graham Oil Company, hereby certifies that the above log is a true and correct log of the formations encountered in drilling the above well as reflected by the Daily Drilling Report.


WILLIAM GRAHAM OIL COMPANY

By F. Duncan  
F. Duncan

Subscribed and sworn to before me this  
21st day of December, 1954

Barbara J. Scott  
Notary Public

My commission expires: December 1, 1956

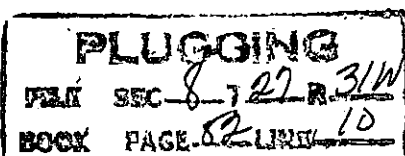

RECEIVED  
STATE CORP  
JAN 1 1955  
HOSKINSON