


Give All Information Completely
Make Required Affidavit
Mail & Deliver Report to:
Conservation Division
State Corporation Commission
211 No. Broadway
Wichita, Kansas

WELL PLUGGING RECORD

NORTH

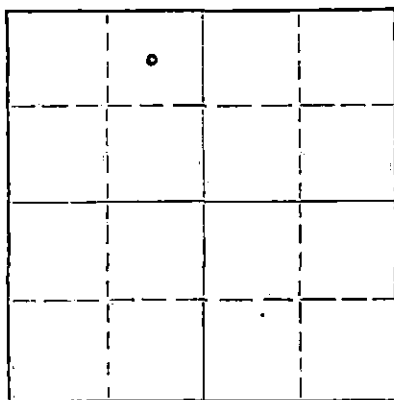

Locate well correctly on above
Section Plat

Haskell County, Sec. 25 Twp 27 S Rg 31 W (E) (W)
Location as "NE/CNW/SW" or footage from lines C NE NW
Lease Owner Hamilton Brothers Inc
Lease Name William C. Nusser Well No. I-25
Office Address 1517 Denver Club Bldg. Denver 2, Colo.
Character of Well (completed as Oil, Gas or Dry Hole) Gas (Not Commercial)
Date well completed _____ 19____
Application for plugging filed Oct. 17 1962
Application for plugging approved Oct. 18 1962
Plugging commenced 2:00 P.M. Oct. 18 1962
Plugging completed 4:00 P.M. Oct. 18 1962
Reason for abandonment of well or producing formation Not sufficient quantity of gas

If a producing well is abandoned, date of last production _____ 19____
Was permission obtained from the Conservation Division or its agents before plugging was commenced? Yes

Name of Conservation Agent who supervised plugging of this well Hugh Scott
Producing formation Winfield-Krider Depth to top 2662 Bottom 2790 Total Depth of Well 5557 Feet
Show depth and thickness of all water, oil and gas formations.

OIL, GAS OR WATER RECORDS

CASING RECORD

FORMATION	CONTENT	FROM	TO	SIZE	PUT IN	PULLED OUT
Krider	Gas & Water	0	2547	7-5/8"	2547	0
Winfield	Gas & Water	0	3180	4-1/2"	3180	0

Describe in detail the manner in which the well was plugged, indicating where the mud fluid was placed and the method or methods used in introducing it into the hole. If cement or other plugs were used, state the character of same and depth placed, from _____ feet to _____ feet for each plug set.

35 sacks of common (Portland) cement mixed and pumped in by The Halliburton Co. to form plug from 2550-3000'. Drilling mud from 175-2550', followed by 15 sack cement plug from 0-175'

RECEIVED
STATE CORPORATION COMMISSION

OCT 28 1962

CONSERVATION DIVISION
Wichita, Kansas

10-23-62

(If additional description is necessary, use BACK of this sheet)

Name of Plugging Contractor The Halliburton Co.
Address Liberal, Kansas

STATE OF Kansas, COUNTY OF Seward, ss.

Haskell Fleetwood (employee of owner) or (owner or operator) of the above-described well, being first duly sworn on oath, says: That I have knowledge of the facts, statements, and matters herein contained and the log of the above-described well as filed and that the same are true and correct. So help me God.

(Signature) Haskell Fleetwood

(Address)

SUBSCRIBED AND SWORN to before me this 22 day of October, 1962

MY COMMISSION

My commission expires EXPIRES FEB. 3, 1965

Lucie C. Spaulding

Notary Public.